

Name N.Y. Brothers Realty Trust

Service No. 128

Address 81 Oak Street

81 OAK ST.

Location

Kind of Pipe

Size 6"

Size of Main 8"

~~Repair~~ ~~Renewal~~ ~~XXXXXX~~ New Service

W. O. # 72

Location DEC 18 1972

Date	Material	Amount	Total	Date	Amount
9/21/72	Labor	83 82		9-12-72	Deposit 340 00
10/2/72	"	30 98		12-18-72	Refund 37 88
	10% O.H.	11 48	126 28		302 92
15'	6" Transite pipe .90		13 50		
1	6" Plug		2 38		
1	6" Coupling		1 78		
1	900 Elbow		5 65		
1	Bag cement 1.98		99		
1	Dozen brick		84		
1 1/2	Ton cold patch 8.00		12 00		
1 1/2	Ton hot top 8.00		12 00		
3	Hrs. Trucking 3.00		9 00		
2	Hrs. shovel 6.50		13 00		
1/2	Hr. compressor 5.00		2 50		
1/2	Hr. roller 2.00		1 00		
	trailer		2 00		
			202 92		

DATE _____


TOWN OF LEXINGTON — BOARD OF PUBLIC WORKS

SEWER DIVISION

Sketch of Service Here

81

Hor # 81

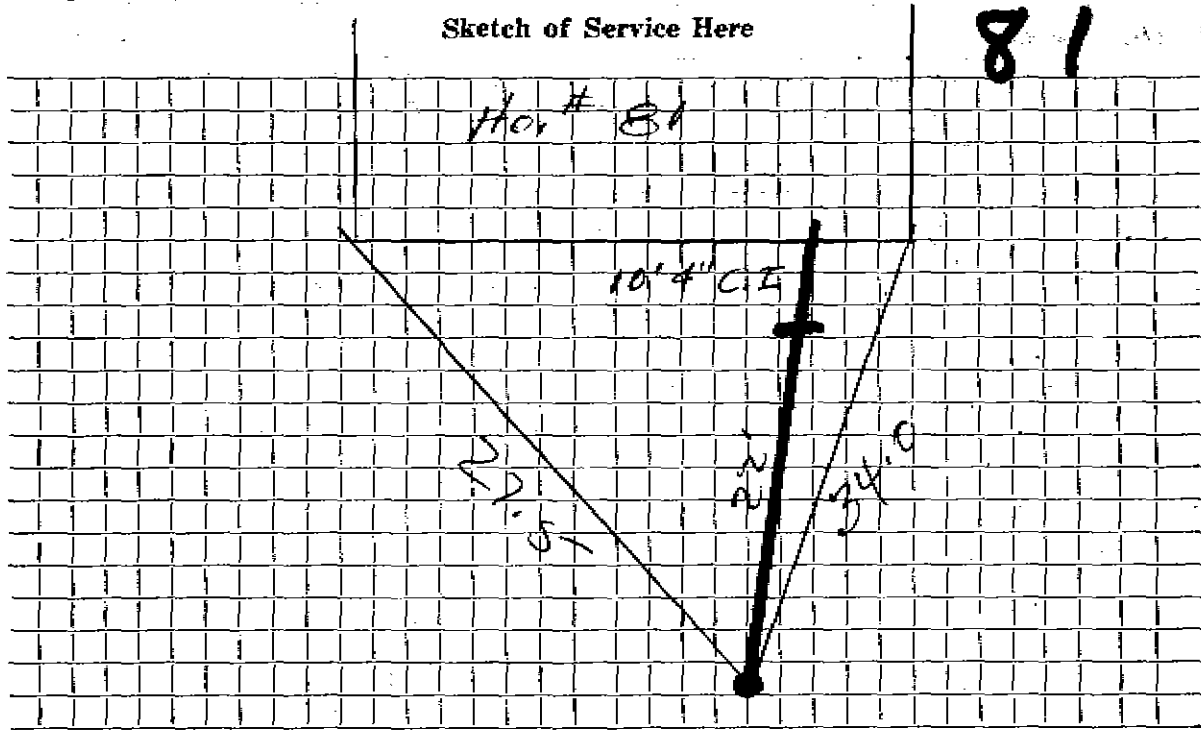

Connection made in Street. Work completed

Remarks:
.....
.....