


DATE _____

TOWN OF LEXINGTON — BOARD OF PUBLIC WORKS

SEWER DIVISION

Sketch of Service Here

82

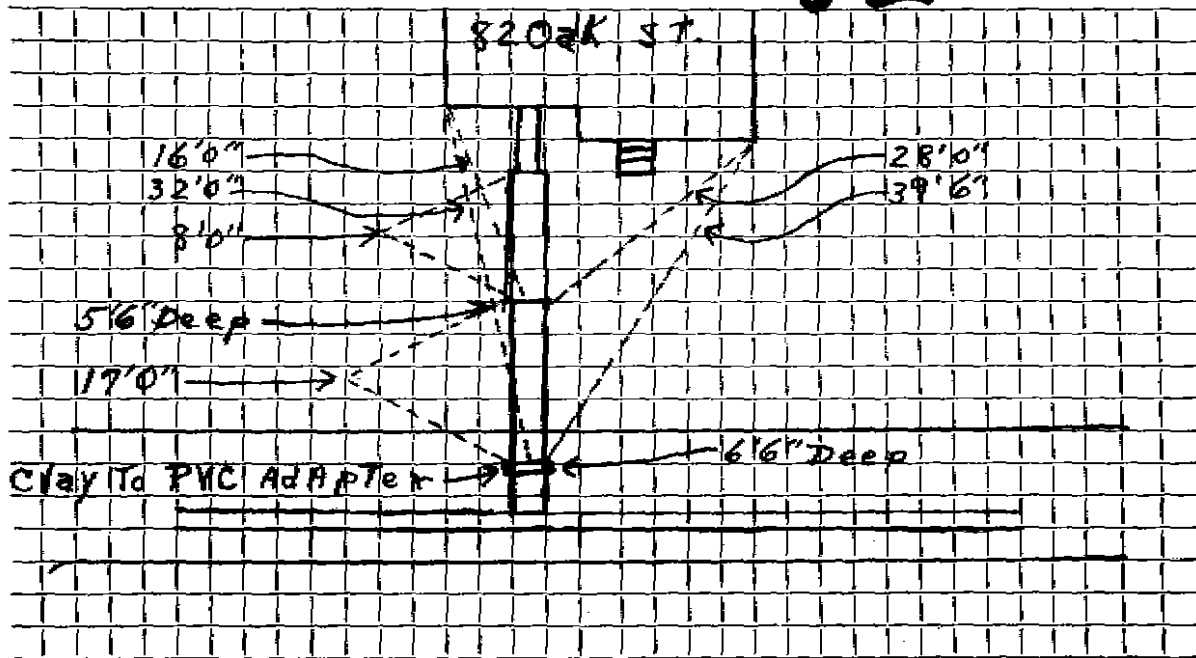

Connection made in Street. Work completed

Remarks: Original Service 9-24-29 (29'-6" Sewer Pipe, 10'-4" C.I. Pipe,
1-6'-1/8" Bend.)