

Name *Joseph S. & Elizabeth A. Simon* Service No. *39 761*  
 Address *151 Oak Street Lexington Mass.*  
**85 OAK ST.** Location

Kind of Pipe \_\_\_\_\_ Size **6"** Size of Main **8"**

~~REPAIR~~ **New Service** Location \_\_\_\_\_

| Date             | Material                       | Amount       | Total        | Date                      | Amount       |
|------------------|--------------------------------|--------------|--------------|---------------------------|--------------|
| <i>6-24-29</i>   | <i>20' 6" Sewer Pipe @ .30</i> | <i>6 00</i>  |              |                           |              |
| <i>Nov 34.29</i> | <i>5' 4" Iron " @.50</i>       | <i>2 50</i>  |              | <i>Oct. 5 1929 - Cash</i> | <i>34 89</i> |
|                  | <i>Sulphur &amp; Jute</i>      | <i>80</i>    |              |                           |              |
|                  | <i>Trucking</i>                | <i>75</i>    | <i>10 05</i> |                           |              |
|                  |                                |              |              |                           |              |
| <i>9/4/29</i>    | <i>36 Hrs. Labor @ .55</i>     | <i>19 80</i> |              |                           |              |
|                  | <i>3 " " @ .60</i>             | <i>1 80</i>  | <i>21 60</i> |                           |              |
|                  | <i>15% Overhead</i>            |              | <i>3 24</i>  |                           |              |
|                  |                                |              | <i>34 89</i> |                           |              |
|                  | <i>Labor</i>                   |              |              |                           |              |
|                  |                                |              |              | <i>5-21-67</i>            | <i>ROOTS</i> |

Gasway Prods. Inc., Lexington

TOWN OF LEXINGTON—BOARD OF PUBLIC WORKS

SEWER DIVISION

DATE Sept. 9, 1929

NO. \_\_\_\_\_


The undersigned applies for the construction of a particular sewer connecting No. 135 Oak St. Street and hereby agrees to comply with the Rules and Regulations governing the construction and use of Particular Sewers, as now or at any future time established by the Board of Selectmen.

Am't. of Estimate \$ \_\_\_\_\_

Am't. Paid \$ \_\_\_\_\_

Mrs Elizabeth Simon Owner

Sketch of Service Here

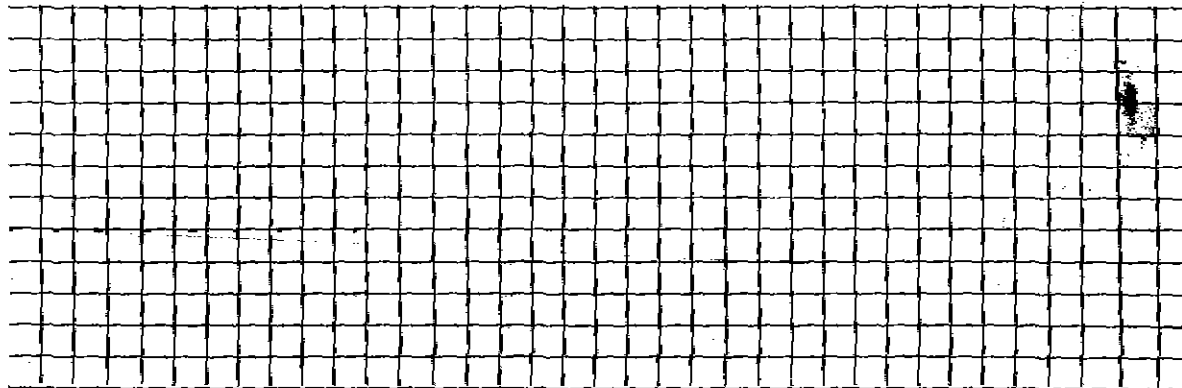

Connection made in \_\_\_\_\_ Street.

Work completed \_\_\_\_\_ 19

Remarks: