

Walter G. Heyand

Service No. 44 0 962

Address

400 Oak Street

86 Oak St.

Location

Kind of Pipe

Size 6"

Size of Main 8"

REPAIRS ~~REPAIRS~~ New Service

Location

Date	Material	Amount	Total	Date	Amount
9-24-29	22 6" Sewer Pipe @.30	6 60			
10-4-29	10 4" Iron " @.50	5 00		Oct 10 1929 - Cash	48 82
	Sulphur & Jute	88			
	Trucking	75	13 23		
11-5-29	53 Hrs. Labor @.55	29 15			
	3 " " @.60	1 80	30 95		
	15% Overhead		4 64		
			48 82		
				3-17-64	L.B.
				9-7-64	ROOTS
				11-18-64	SLUDGE
	Labor				7 39

Medical Press, Inc.

**TOWN OF LEXINGTON—BOARD OF PUBLIC WORKS**  
**SEWER DIVISION**

DATE \_\_\_\_\_

NO. \_\_\_\_\_


The undersigned applies for the construction of a particular sewer connecting No. \_\_\_\_\_  
Street and hereby agrees to comply with the Rules and Regulations governing the construction and use of Particular  
Sewers, as now or at any future time established by the Board of Selectmen.

Am't. of Estimate \$ \_\_\_\_\_

Am't. Paid \$ \_\_\_\_\_

\_\_\_\_\_  
Owner

**Sketch of Service Here**

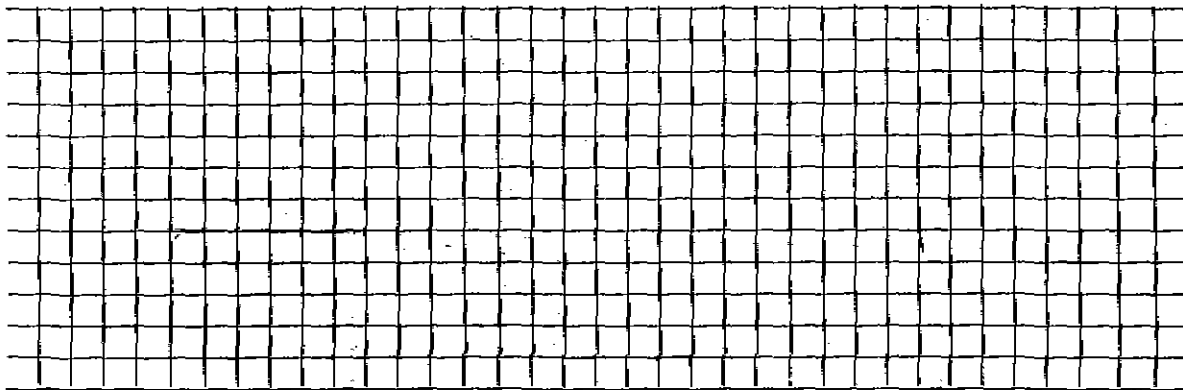

Connection made in \_\_\_\_\_ Street.

Work completed \_\_\_\_\_ 19

Remarks: