

10 Oakland Street

Location Same

10 Oakland ST.

Kind of Pipe		Size 6"		Size of Main		Location		Amount	
Date	Material	Amount	Total	Date	Location	Amount	Total	Date	Amount
May 8	26 hrs. Labor @ 50¢	13 00		May 7 1935	Deposited	80 00			
47	" @ 55¢	26 85		" 23 1935	Refounded 3.80	3 80			
22	" @ 60¢	<del>13 20</del>	52 05			76 20			
	10% Overhead on labor		5 20						
56	6" Sewer Pipe @ 20¢	11 20							
10	4" Iron " @ 45¢	4 50							
	Sulphur & Jute	75							
	Trucking	2 50	18 95						
			76 20						
			3 80						
			80 00						
	Labor								

May 23 1935 - Refounded

TOWN OF LEXINGTON—BOARD OF PUBLIC WORKS

SEWER DIVISION

DATE May 4 1935

NO. \_\_\_\_\_


The undersigned applies for the construction of a particular sewer connecting No. 10 Oakland St. Street and hereby agrees to comply with the Rules and Regulations governing the construction and use of Particular Sewers, as now or at any future time established by the Board of Selectmen.

Am't. of Estimate \$ 80.00

Am't. Paid \$ 80.00

George Harman Owner

Sketch of Service Here

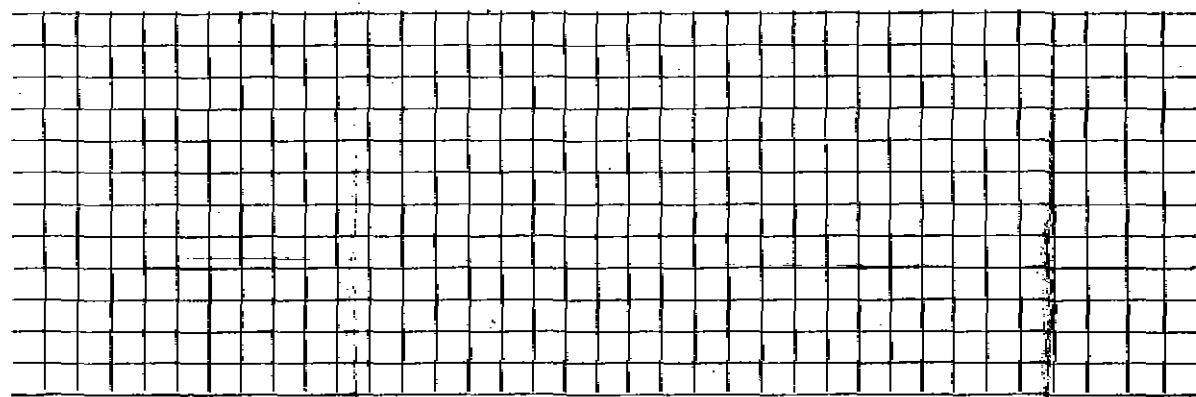

Connection made in \_\_\_\_\_ Street. Work completed \_\_\_\_\_ 19

Remarks: