

Name **J. Alan Cooper**

Service No. **103**

Address **1 1/2 Oakland St.**

**14 OAKLAND ST.**

Location

Kind of Pipe

Size **6"**

Size of Main

~~Renewal~~ ~~Work Order~~ W.O. # **6879**


Location **DEC 22 1969**

Date	Material	Amount	Total	Date	Amount
9/24/69	Labor		103 44	9-22-69	400 00
	10% O.H.		10 34	12-22-69	189 60
70'	Transite pipe .88		61 60	11-6-59	210 40
1'	Nipple		1 21	<b>18' 6" Sewer Pipe</b>	
2	1 1/2 Bends 4.09		8 18		
1	22 1/2 Elbow		2 35		
1/2	Bag cement 1.55		78		
1	Yd. Loan		3 50		
5	Lbs. Seed 1.10		5 50		
1	Hr. Trucking		3 00		
1	" Loader		4 00		
1	" Shovel		6 50		
			<u>210 40</u>		

DATE \_\_\_\_\_

**TOWN OF LEXINGTON — BOARD OF PUBLIC WORKS**  
**SEWER DIVISION**

Sketch of Service Here

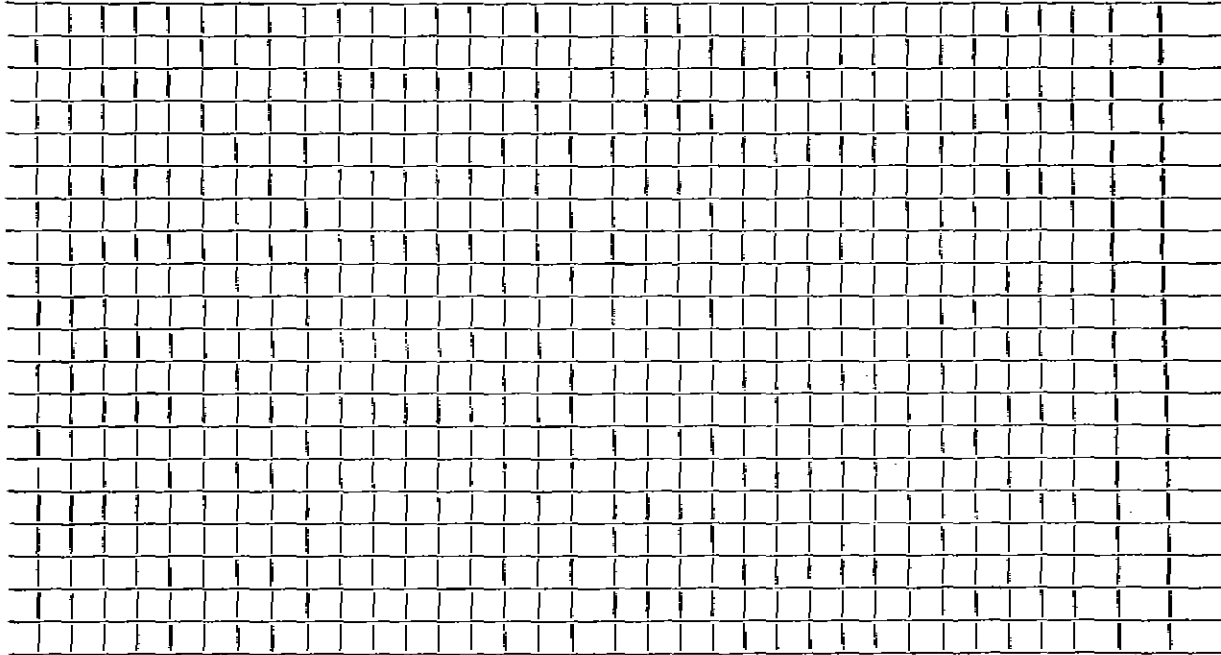

Connection made in ..... Street. Work completed .....

Remarks: *Original Service 11-10-43 98'-6" V.C. Pipe, 1-6" x 6" Wye* .....

.....  
.....