

Name **Cooney Construction Corporation**

Service No. 125

Address 17 Oakland Street (Greek Orthodox Church)

17 Oakland St.

Location

Kind of Pipe

Size **6"**

Size of Main

~~XXXXXXXXXX~~ — New Service W.O. # 2765


Location FEB 10 1975

Date	Material	Amount	Total	Date	Amount
11-21-74	Labor	149 91		11-21-74	175 00
12-06-74	Labor	42 54	192 45	1-4-75	117 85
	10% O.H.	19 25	19 25		292 85
	30' 6" Transite Pipe	1 24	37 20		
	3' 6" Transite w/coupling	1 60	4 80		
	1 Bag Cement		2 20		
	15 Bricks	0 13	1 95		
	3 Hrs. Trucking	3 00	9 00		
	1 Hr. Trucking	1 50	1 50		
	3 Hrs. Town Shovel	6 50	19 50		
	1 Hr. Compressor	5 00	5 00		
			<u>292 85</u>		
5/13 75	75' - 6" A.C.P.				
	10' - 4" C.I.				

DATE _____

TOWN OF LEXINGTON — BOARD OF PUBLIC WORKS
SEWER DIVISION

Sketch of Service Here **17**

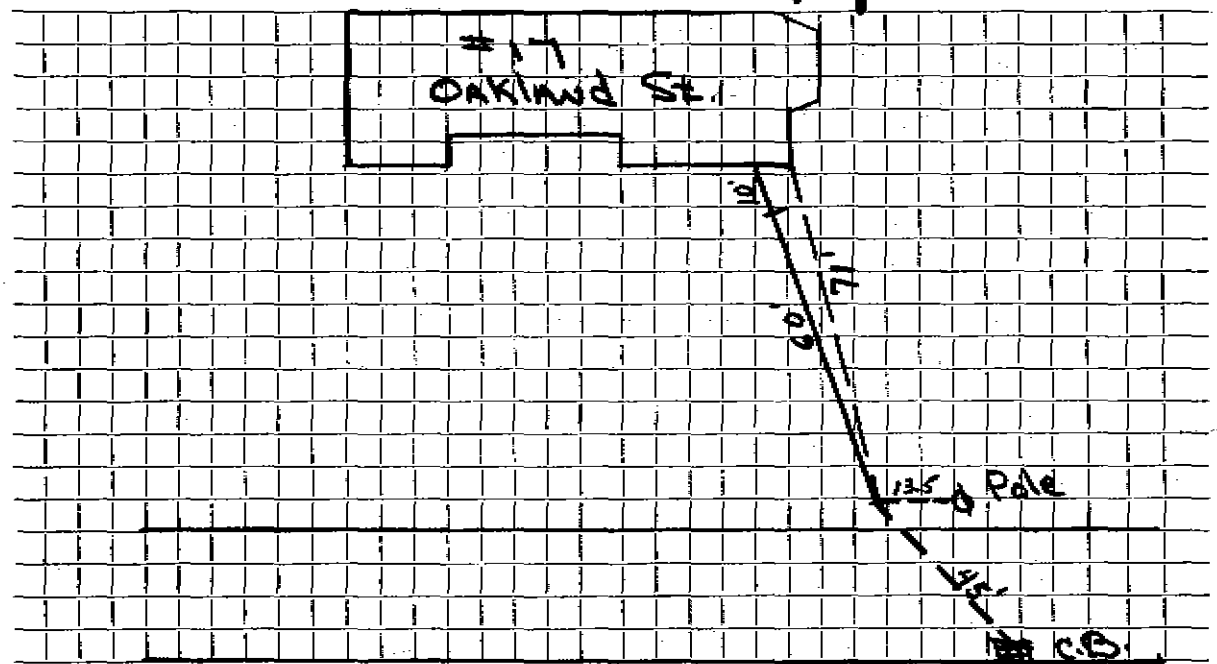


Connection made in Street. Work completed

Remarks:
.....
.....

SEWER DIVISION

Sketch of Service Here **17**

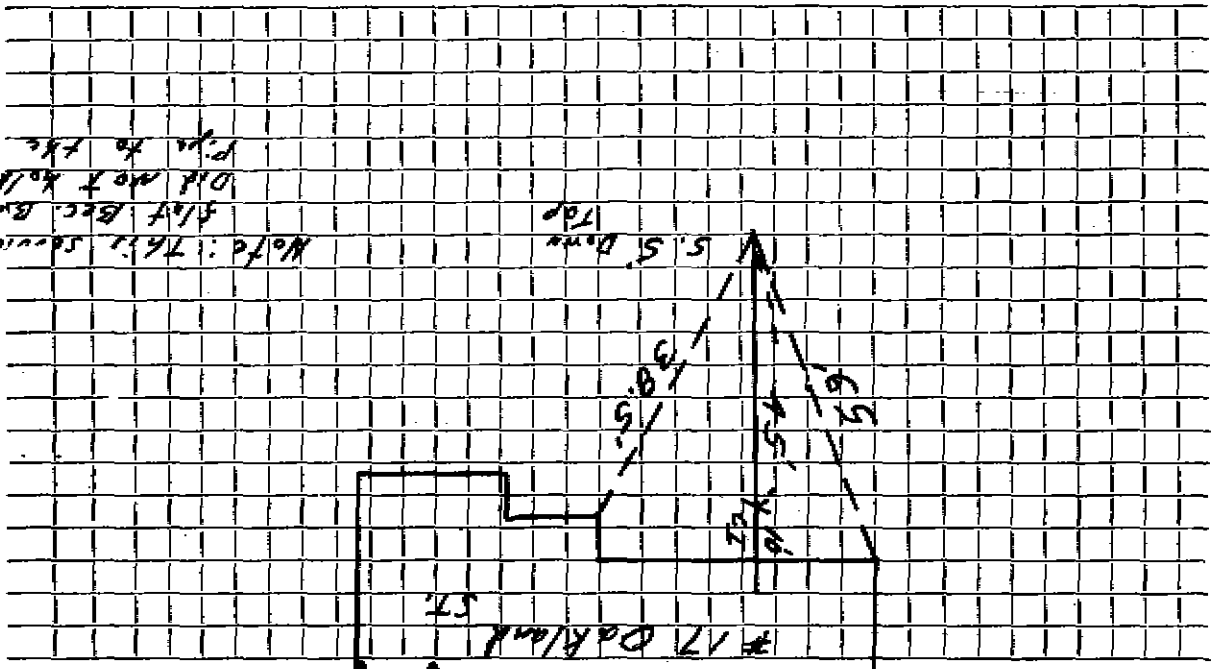

Note: This service was laid
 first B.C.C. Building contractor
 did not hold his 9" C.C.
 pipe to the grade given.

Work completed

Street

Connection made in *Oakland*

Remarks: