

Name

Service No.

Address 20 Oakland St

Location

Kind of Pipe 6" PVC SDR 35

Size 6"

Size of Main


Repair ~~Renewal~~ New Service

Location

Date	Material	Amount	Total	Date	Amount
11/15/21	4 x 6" ferro				
	6" cleanout w/ tee w/c 6" 220 bend				
	6" 220 bend				
	6" 220 bend				
	6" 110 bend				
	6 x 6" ferro to clay stub ↳ (1 ft)				

TOWN OF LEXINGTON — BOARD OF PUBLIC WORKS  
SEWER DIVISION

Sketch of Service Here

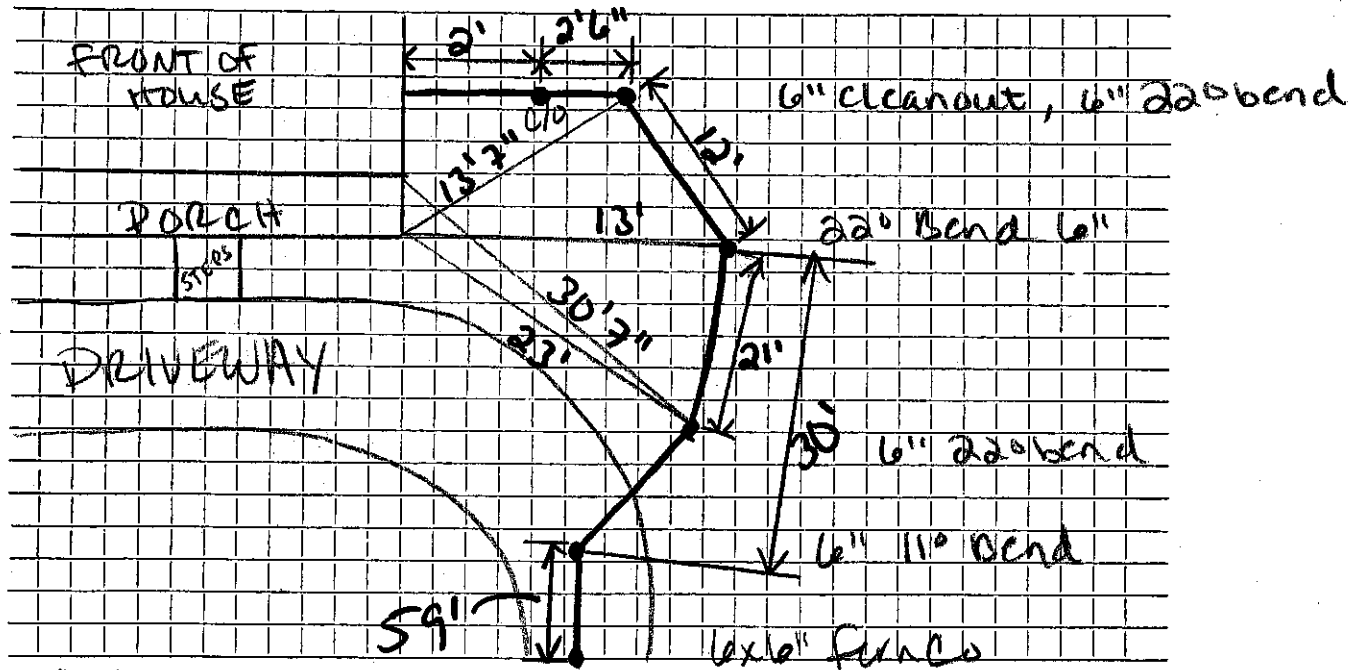

Connection made in ... Oakland St ... Street.

Work completed .....

Remarks: