

Name

Service No.

Address 21 Oakland Street

#21 Oakland St.

21 OAKLAND ST.

Location

Kind of Pipe

Size 6"

Size of Main

Repair—Renewal—New Service

Location

Date	Material	Amount	Total	Date	Amount
12-16-48	229'-6" Sewer Pipe				
	1 6" Elbow				
	1 6"-1/8" Bend				


DATE \_\_\_\_\_

TOWN OF LEXINGTON — BOARD OF PUBLIC WORKS

SEWER DIVISION

Sketch of Service Here **21**

GLEN  
R.D.

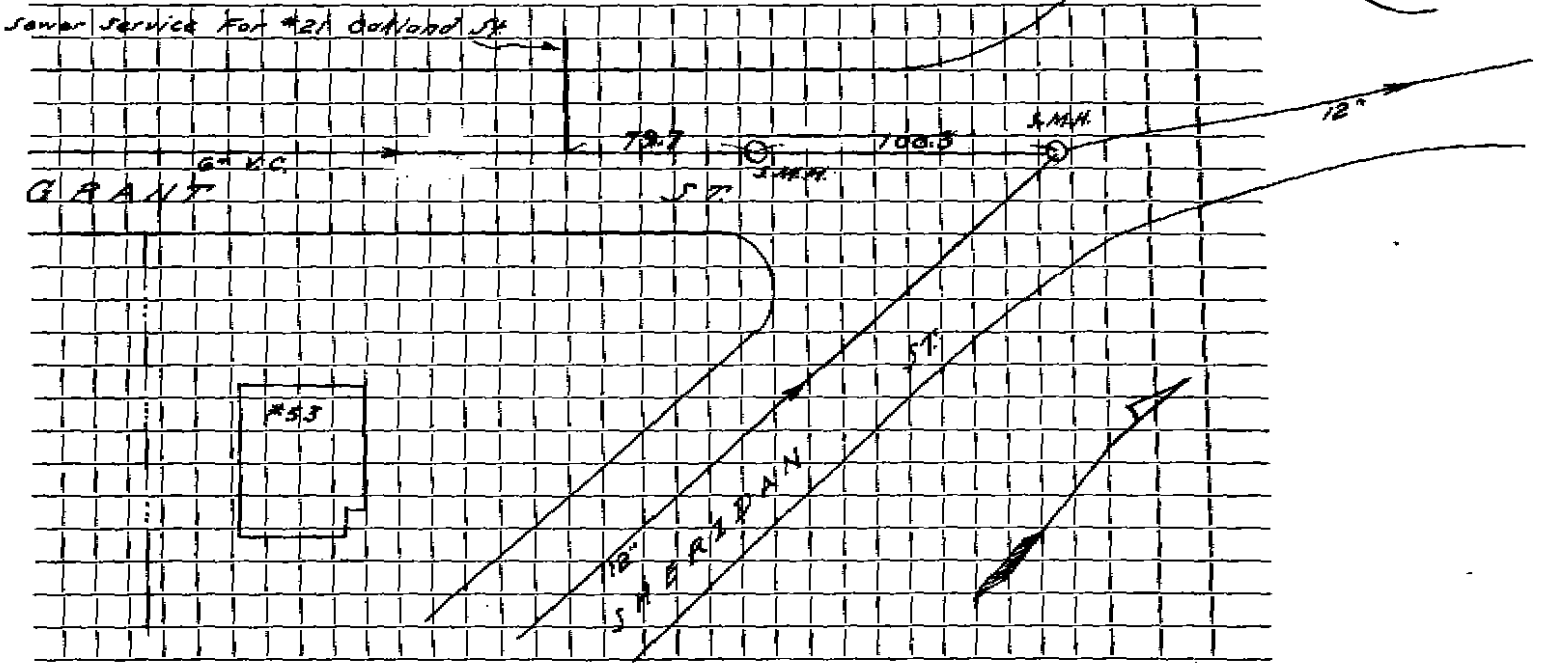

Connection made in ..... Street. Work completed .....

Remarks: .....  
.....  
.....