

Service No.

Name 23 Oaklind St.
Address

Location

Kind of Pipe PVC
Repair - Renewal - New Service

Location


Date	Material	Amount	Total	Date	Amount
7-30-03	78' 6" PVC				
	1-6x6x6 Wye				
	2x3x4 Fenc				
	1-6x6 PVC				
	1-6x6 PVC Fenc				

Remarks:

Connection made in

Street.

Work completed

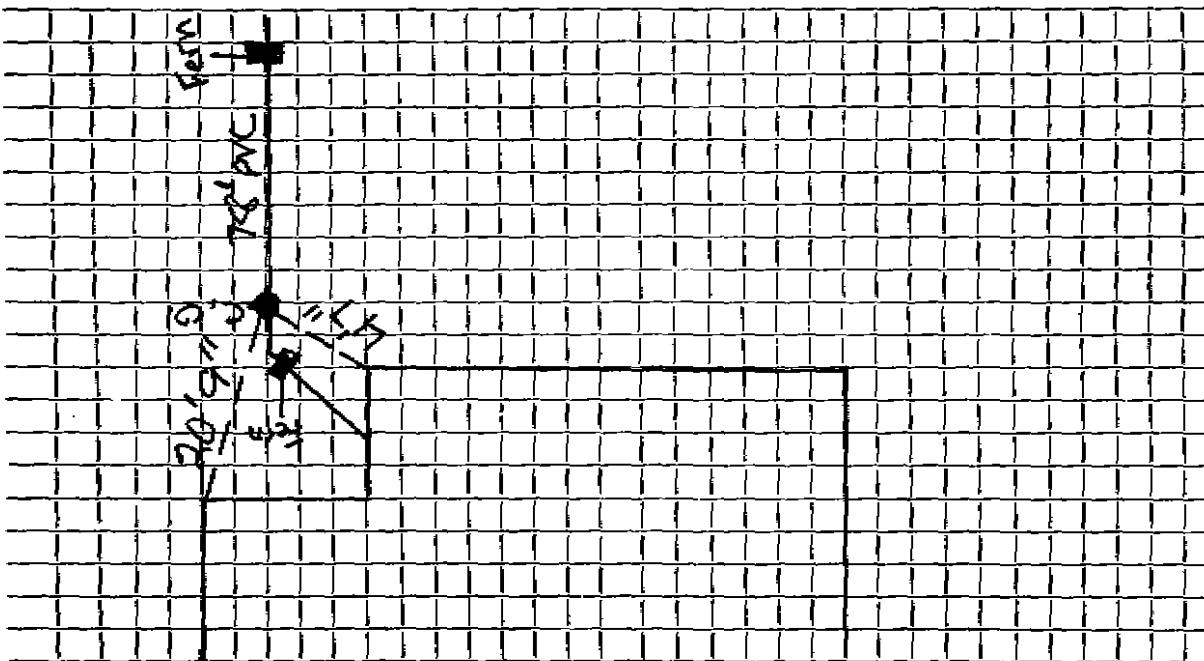

Sketch of Service Here

SEWER DIVISION

TOWN OF LEXINGTON — BOARD OF PUBLIC WORKS

DATE