


DATE _____

TOWN OF LEXINGTON — BOARD OF PUBLIC WORKS

SEWER DIVISION

Sketch of Service Here **25**

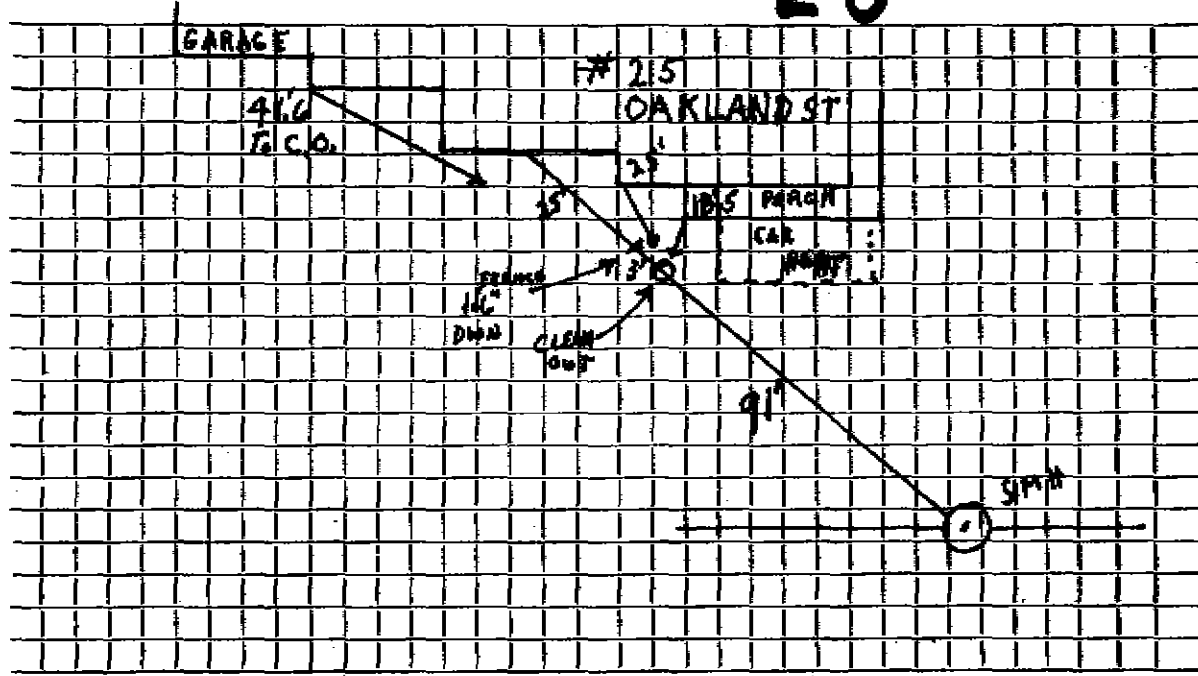

Connection made in OAKLAND ST Street. Work completed _____

Remarks: ARLEX GAVE INFO. SCH 80 PVC FROM C.O. TO HOUSE 9" UNDER DRIVEWAY