

Name Marion L. Meeks

Service No. 174

Address 26 Oakland Street

26 OAKLAND ST.

Location

Kind of Pipe

Size 6"

Size of Main

~~Repair~~—Renewal—~~W. O. #5910~~ W. O. #5910

Location AUG 5 1968

Date	Material	Amount	Total	Date	Amount
2/6/67	Labor	60.52		11-24-67	250 00
2/7/67	"	44.71		8-5-68	19 32
4/1/68	"	25.61	130 84		230 68
	10% O.H.	13 08	143 92		
27'	6" Transite pipe @.88		23 76		
1	Bag Cement		1 55		
10	Brick		45		
3	Yds. Loam @ 3.50		10 50		
7	Hrs. Trucking @ 3.00		21 00		OUTSIDE
3	Hrs. Shovel @ 6.50		19 50	12/6/67	Labor 45 39
1	Hr. Compressor		5 00		5' 6" Transite pipe @.88 4 40
1	Hr. Roller & Trailer		5 00		1 Hr. Trucking 3 00
			230 68		52 79
				3/16/90	Response + Measure <i>add</i>
				10-31-66	Roots
				11-26-65	Garbage


DATE \_\_\_\_\_

TOWN OF LEXINGTON — BOARD OF PUBLIC WORKS

SEWER DIVISION

Sketch of Service Here

26

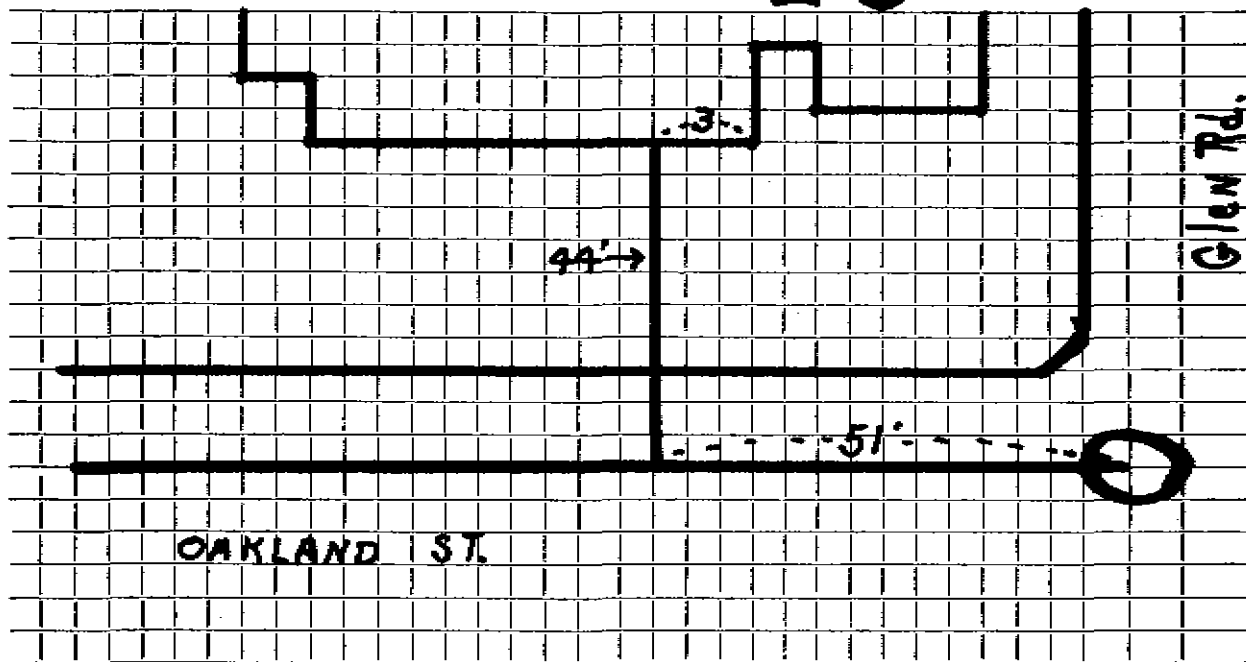

Connection made in ..... Street. Work completed .....

Remarks: Original Service 3-1-37 (46'-6" Sewer Pipe)