




DATE \_\_\_\_\_

TOWN OF LEXINGTON — BOARD OF PUBLIC WORKS

SEWER DIVISION

Sketch of Service Here

29

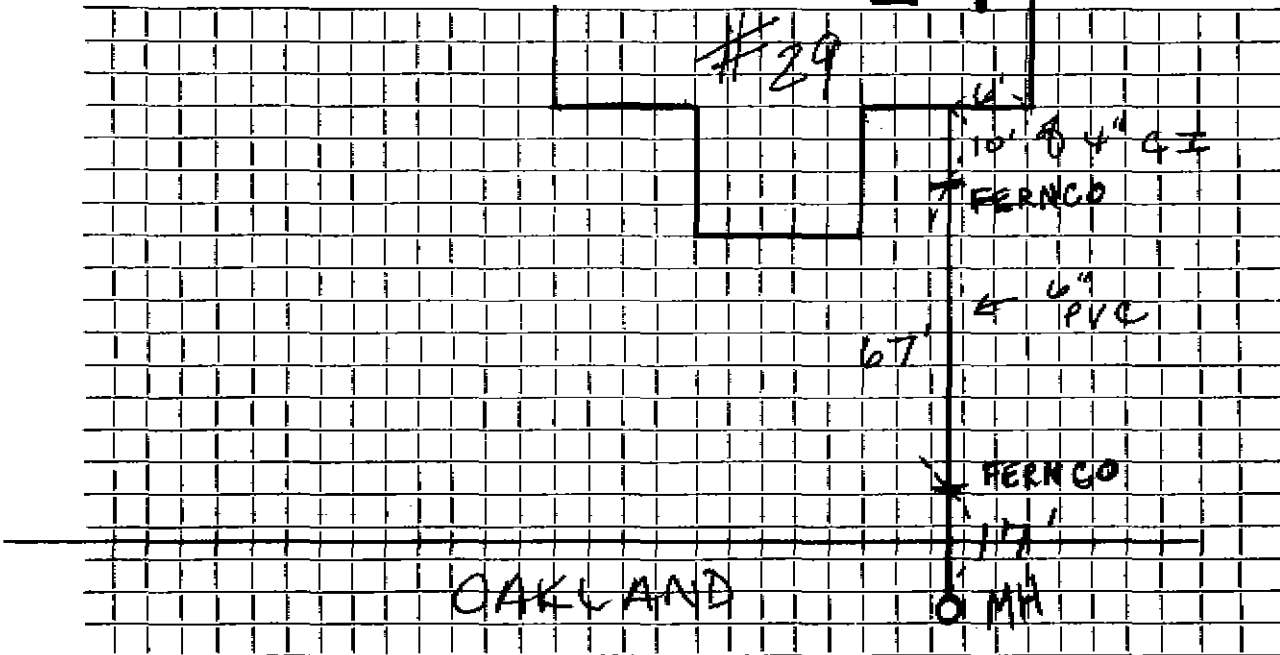

Connection made in ..... Street. Work completed .....

Remarks: Original Service 11-18-30 (82'-6" Sewer Pipe)