

Name Michael Gill

Service No. 63

Address #31 OAKLAND ST.

31 Oakland ST.

Location

Kind of Pipe ACP

Size 6"

Size of Main 8"

~~XXXXXXXXXXXX~~ New Service Trebino #3541

Location NOV 24 1980

Date	Material	Amount	Total	Date	Amount
2/28/80	20' of 6" ACP @ 14.00/ft	280.00	280.00	10-14-80	Deposit 280.00
10-28-80	111' P.V.C. Pipe			7-28-80	
	1 45° x 6" Elbow				20' 6" Transite
	1 6" x 6" AC-PVC Adaptor				1 6" x 8" Wye


31 OAKLAND

DATE _____

TOWN OF LEXINGTON — BOARD OF PUBLIC WORKS

SEWER DIVISION

Sketch of Service Here **31**

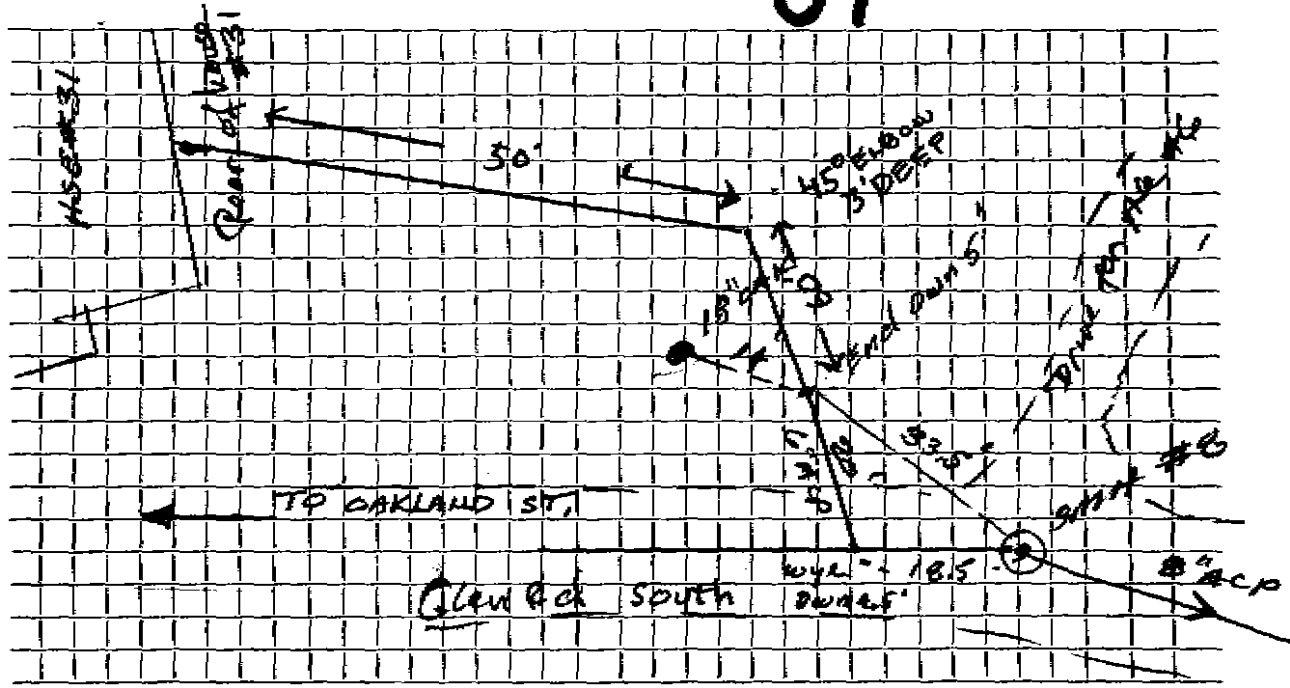

Connection made in Clen Rd. South Street. Work completed

Remarks:
.....
.....