

Name Francis C. Kensley

Service No. 59

Address #33 Oakland St

33 Oakland ST

Location

Kind of Pipe

Size 6"

Size of Main 8"

~~Sanitary Sewer~~ New Service Trebino #3538

Location NOV 24 1980

Date	Material	Amount	Total	Date	Amount
7/29/80	22 LF of 6" pipe @ 14.00		308.00	10-7-80	Deposit 308.00
10-8-80	50' P.V.C. pipe			7-29-80	22' 6" Transite
				6-7-01	Main Blocked pipe broken - repair made 6-8-01 still some stones in pipe

33 OAKLAND


DATE _____

TOWN OF LEXINGTON — BOARD OF PUBLIC WORKS

SEWER DIVISION

Sketch of Service Here

33

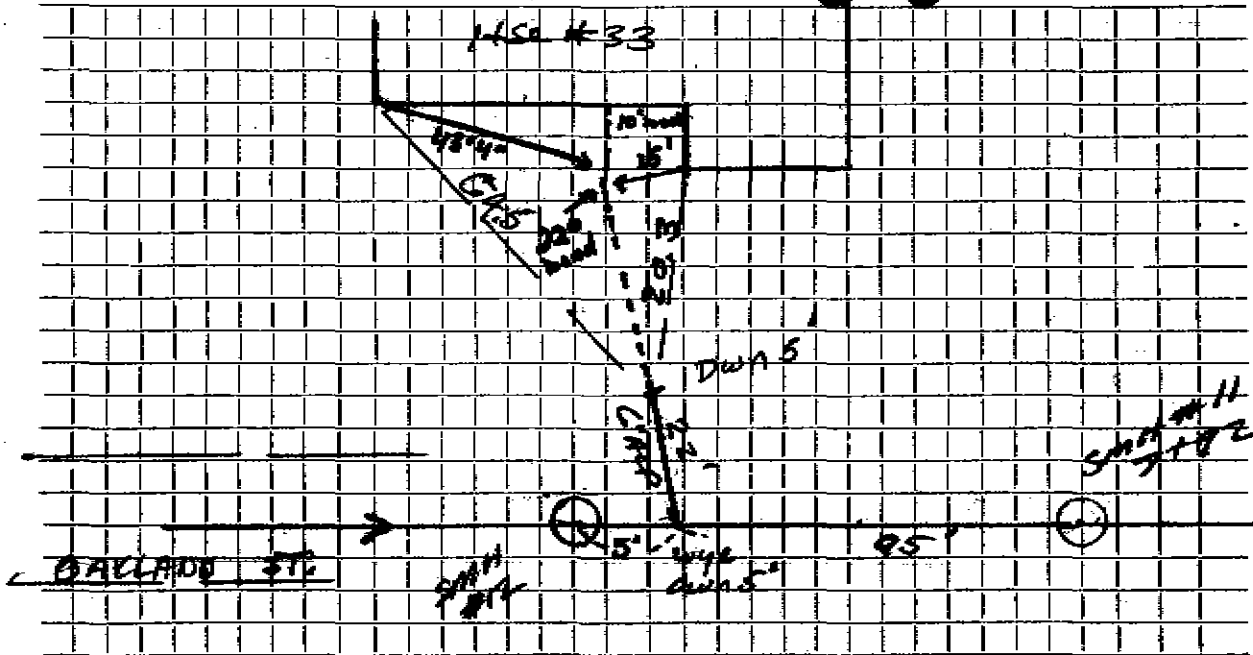

Connection made in OAKLAND ST Street. Work completed

Remarks: From house 10' iron - 25' PVC to 22" band - 25' to AC Pipe

3'3" deep 9T Iron Pipe