

Name Mr. Michael Goulet

Service No.

Address 6 Oakland Street

6 Oakland ST.

Location

Kind of Pipe PVC & CI

Size 6"

Size of Main

Repair—Renewal—~~New/Service~~ #4668 Bruce J. McKee, Inc.

Location

Date		Material	Amount		Total	Date		Amount
8/23/88	43'	6" PVC						
		6"x6" CI to CI FERNCO						
		6x6x6 PVC WYE						
		6" Clean-out with cap				7/27/88	22'6" PVC Pipe	
							2 Fernco 6" Clay to 6" PVC	


7/27/88

DATE _____

TOWN OF LEXINGTON — BOARD OF PUBLIC WORKS

SEWER DIVISION

Sketch of Service Here

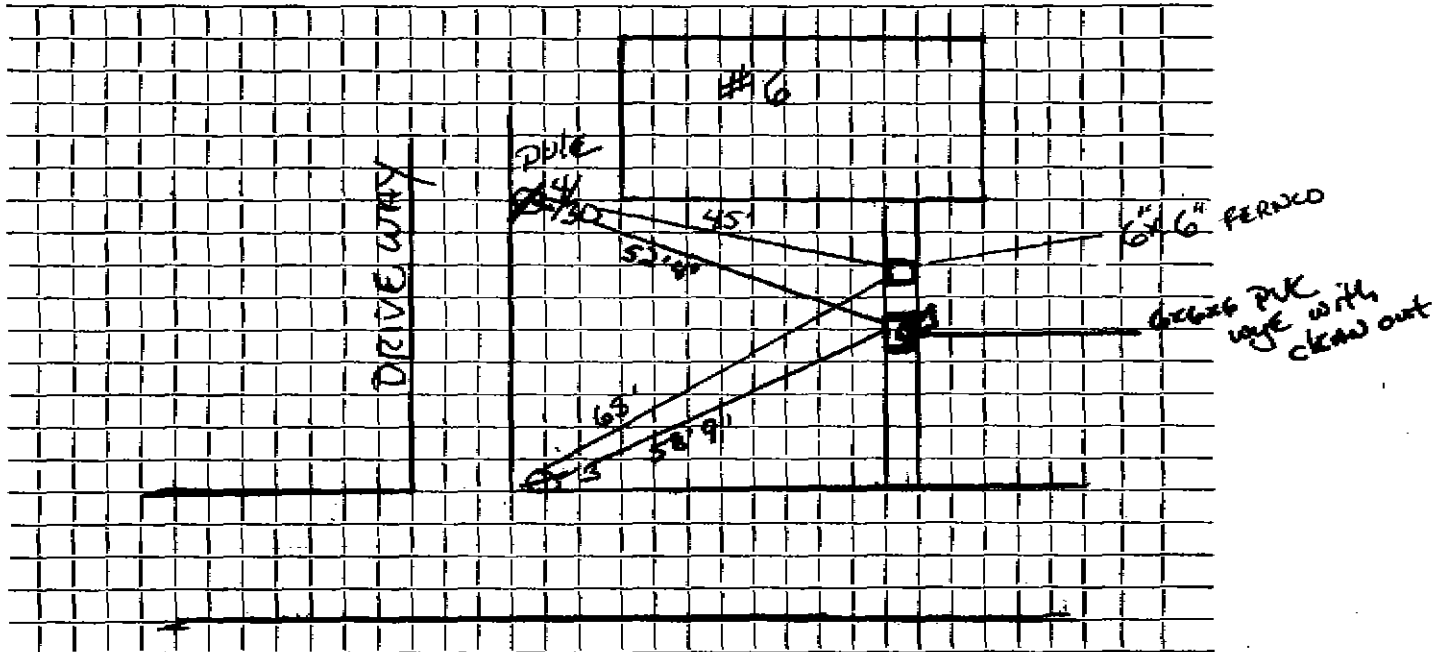

Connection made in Street. Work completed

Remarks:

.....

.....