


DATE 6/4/19

TOWN OF LEXINGTON — BOARD OF PUBLIC WORKS  
SEWER DIVISION

Sketch of Service Here

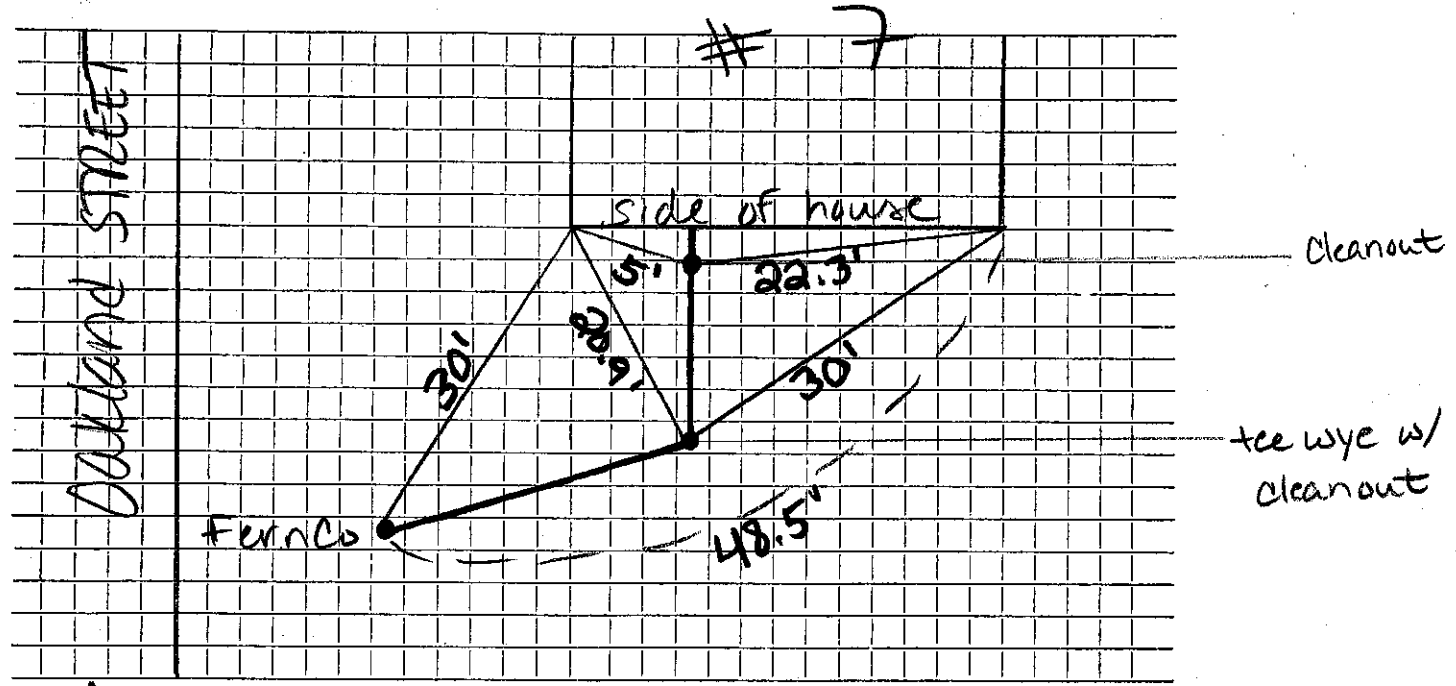

Connection made in ... Dakland Street. Work completed .....

Remarks: .....  
.....  
.....

Name

Contractor: Express Excavation

Service No.

Address

7 Oakland St

Location

Kind of Pipe

SDR 35 PVC

Size

6"

Size of Main

Repair—Renewal—New Service

Location

Date

Material

Amount

Total

Date

Amount

6/4/19

4" SDR 21 Cleanout

6" SDR 35 PVC

6" tee wye w/  
cleanout (45°)

6" SDR 35 PVC

6" ferrule