

Name

Berkeley

Service No.

Address 8 Oakland Street

8 Oakland St.

Location

Kind of Pipe

Size 6"

Size of Main

Repair—Renewal—New Service
Clearway #4555

Location


Date	Material	Amount	Total	Date	Amount
7/8/86	1 4 x 6 Iron PVC Fernco				
	26' 6" PVC Pipe				
7/15/86	9' 6" PVC Pipe				OUTSIDE
	1 6' x 6' PVC - PVC Fernco			5/28/80	Labor
	1 6 x 6 PVC Trans Fernco				2 6" x 10' Transite pipe
	18 yds. Gravel				3 6" x 11 ⁰ Transite Bands
	1 yd. Loam				1 6" x 6" Nipple
					1 6" x 5' Nipple
					1 6" Saddle
					1 6" Rubber Transite to Clay Patch 12' x 27'

TOWN OF LEXINGTON — BOARD OF PUBLIC WORKS

SEWER DIVISION

Sketch of Service Here

8

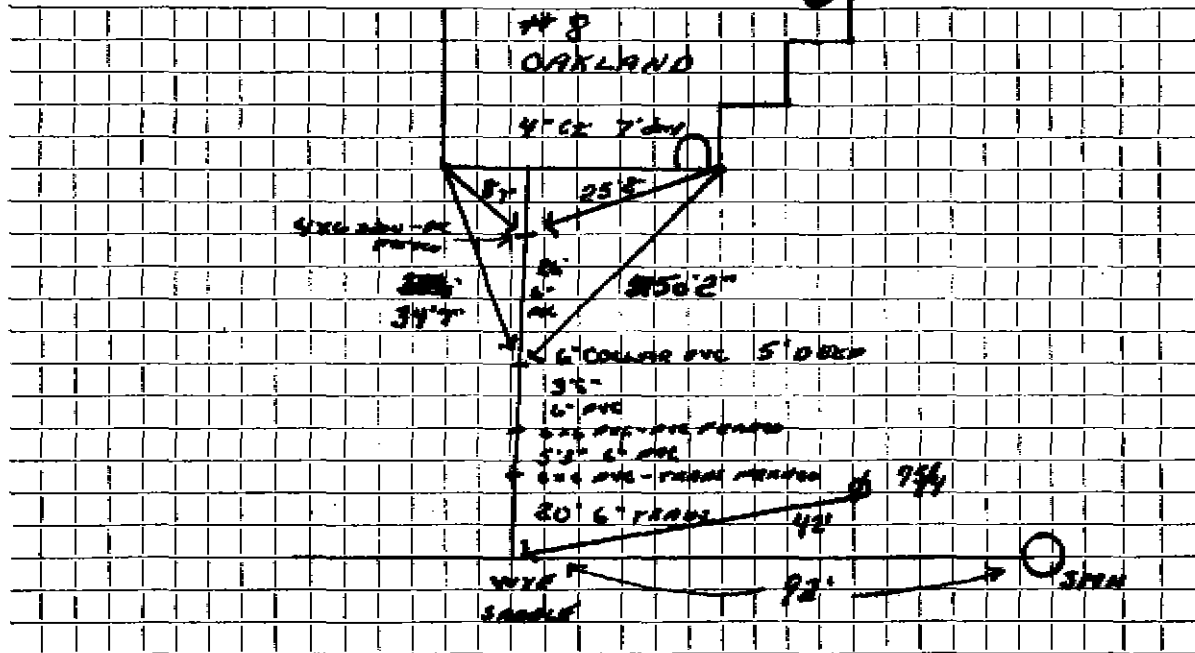

Connection made in Street. Work completed

Remarks:

.....

.....