

TOWN OF LEXINGTON — BOARD OF PUBLIC WORKS

SEWER DIVISION

9 OAKLAND ST.

Sketch of Service Here **9**

REPAIR


MATERIAL

24'6" 6" PVC

2 6X6 CLAY-PVC FERROLO

1 90° PVC ELBOW

4/22/86

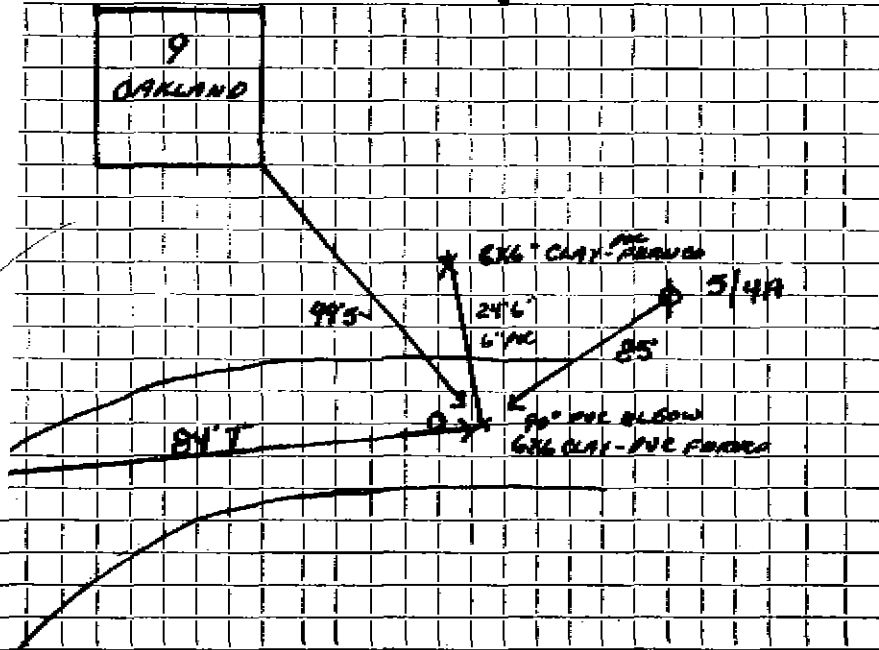

Connection made in Street. Work completed

Remarks:

.....

.....