




DATE \_\_\_\_\_

**TOWN OF LEXINGTON — BOARD OF PUBLIC WORKS**  
**SEWER DIVISION**

Sketch of Service Here

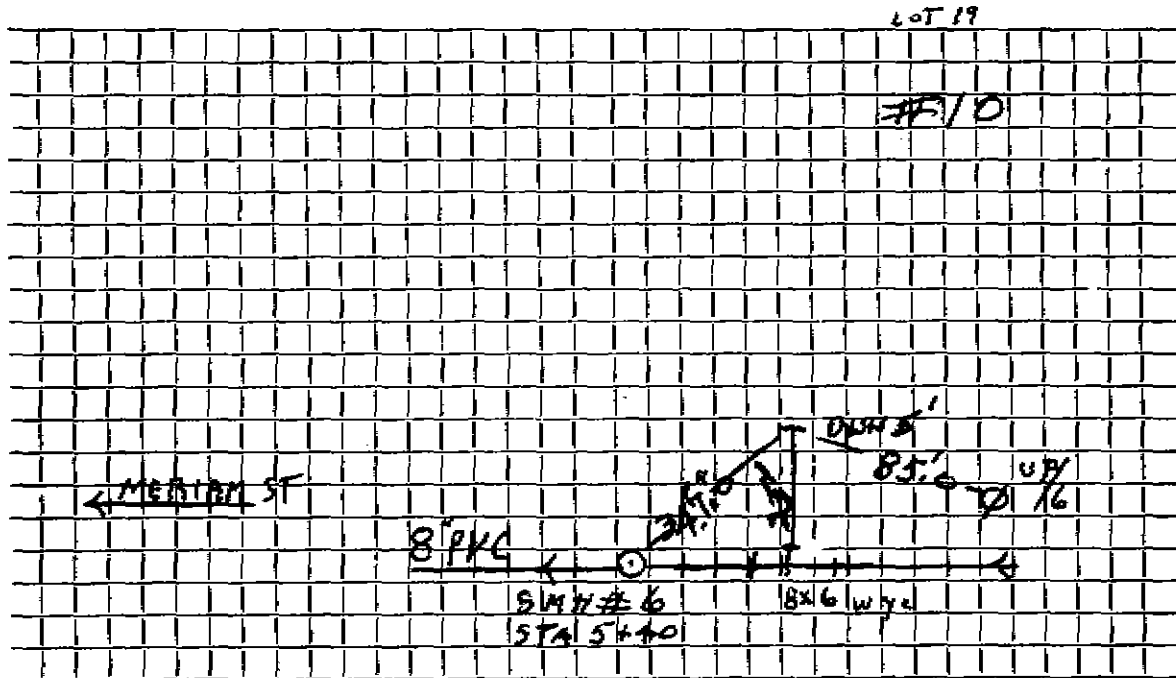

Connection made in OAKMOUNT Circle Street.

Work completed 7/15/08

Remarks: .....

.....

.....