


DATE _____

TOWN OF LEXINGTON — BOARD OF PUBLIC WORKS
SEWER DIVISION

Sketch of Service Here

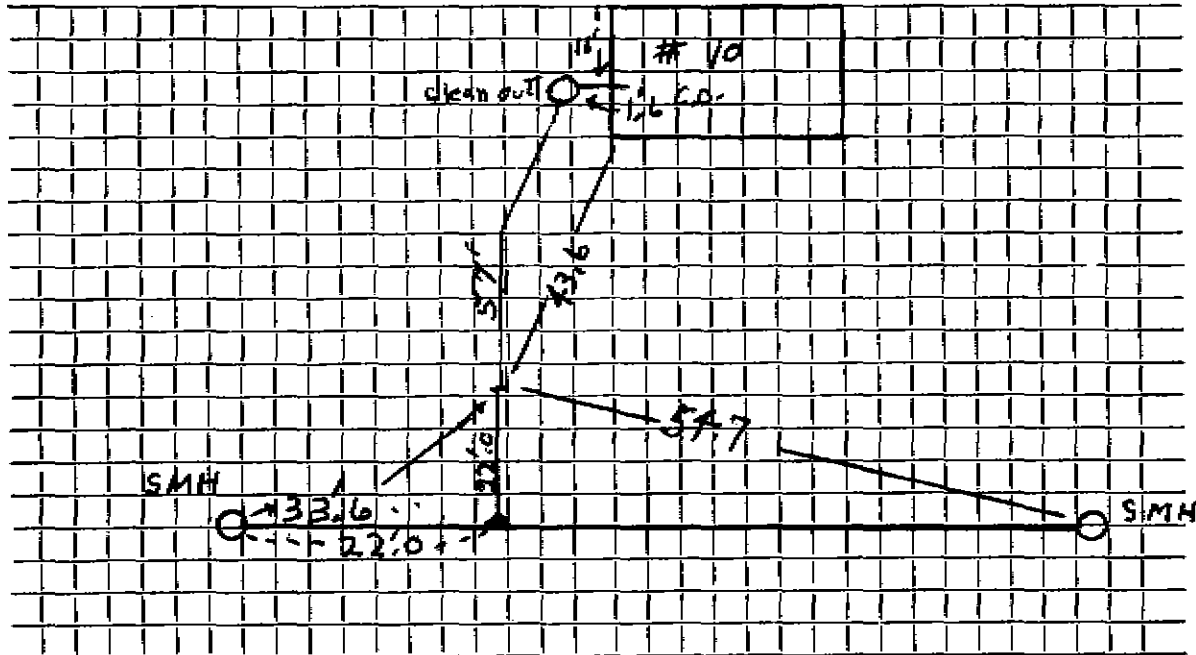

Connection made in OAKMONT CIR Street. Work completed SEWER MAIN J-ly. 2008

Remarks: Service J. McLaughlin 7/08