


DATE _____

TOWN OF LEXINGTON — BOARD OF PUBLIC WORKS

SEWER DIVISION

Sketch of Service Here

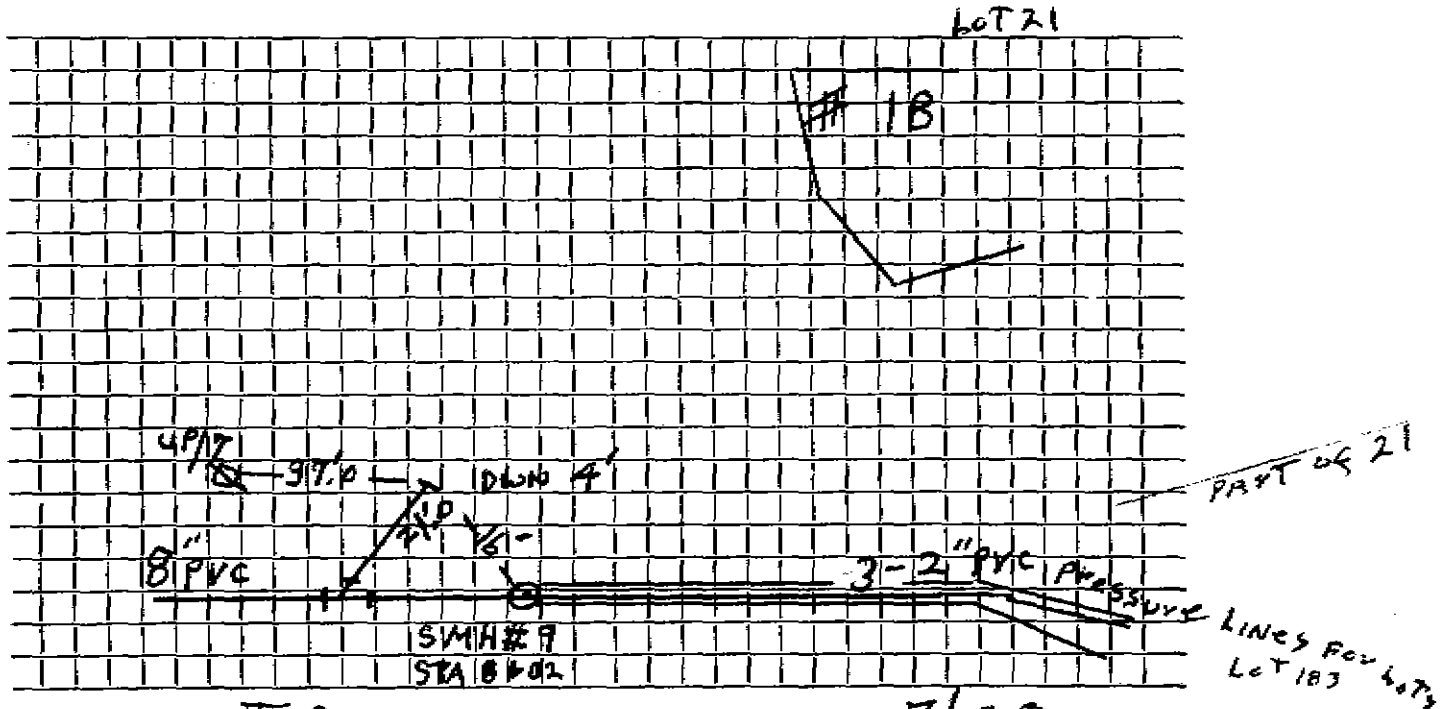

Connection made in OAKMOUNT CIR. Street. Work completed 7/08

Remarks: MAY USE 2" FORCE MAIN ON LOWER LOT 21 / SEC. 2nd SERVICE CARD