


DATE _____

TOWN OF LEXINGTON — BOARD OF PUBLIC WORKS SEWER DIVISION

2

Sketch of Service Here

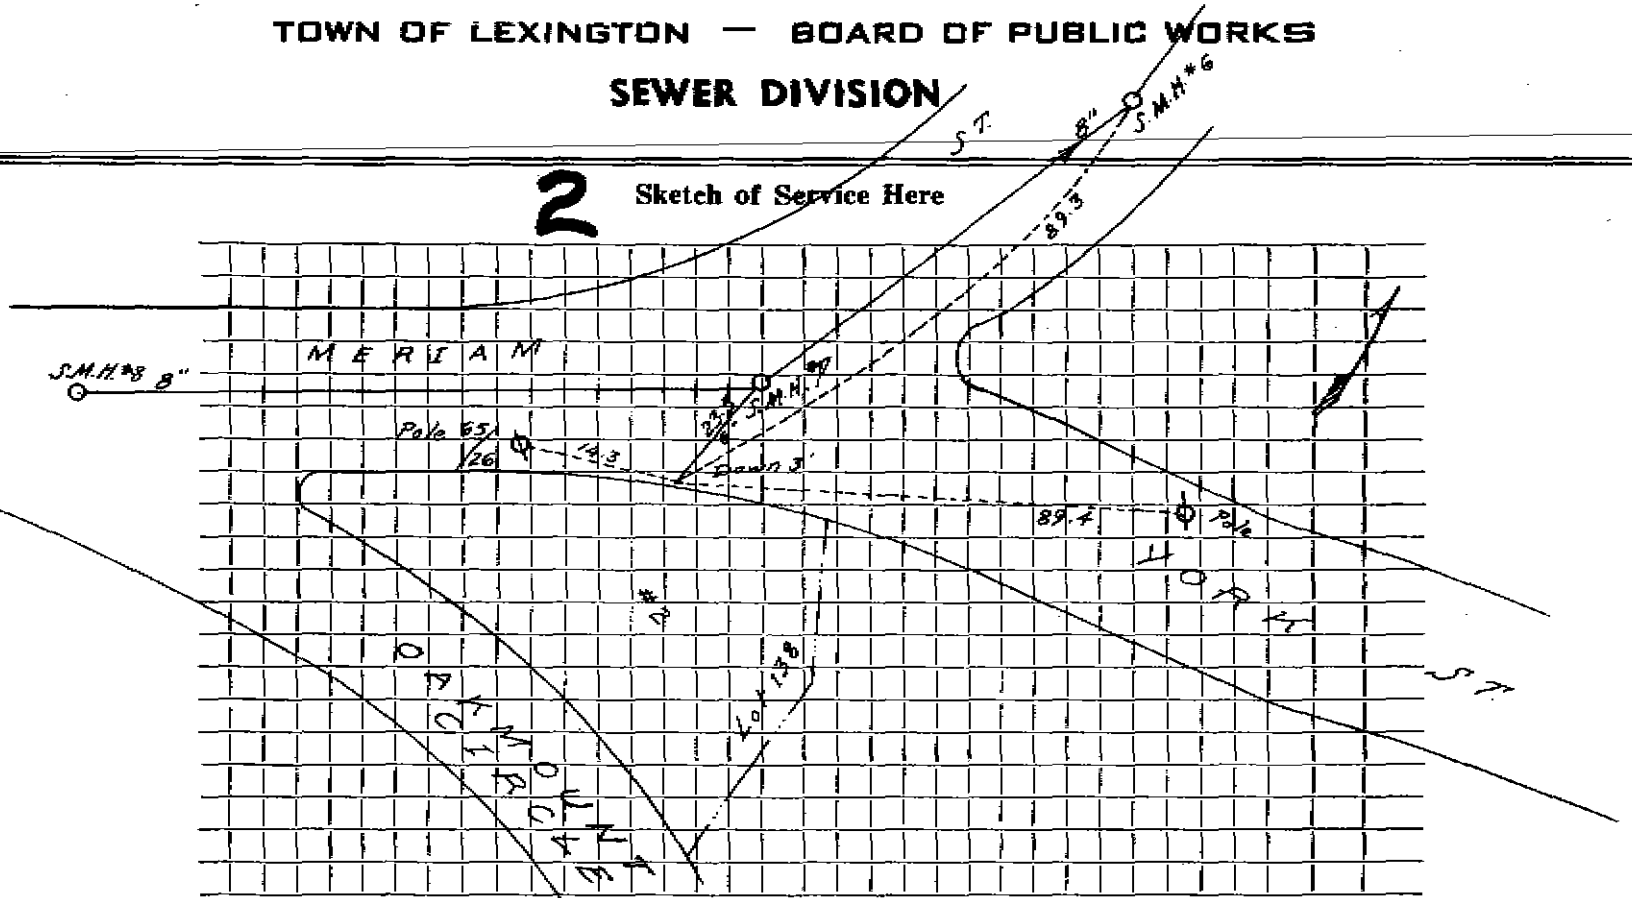

Connection made in Street. Work completed

Remarks:

.....

.....