

Name Peter E. Kostorizos

Service No.

Address 36 Oakmount Circle

36 OAKMOUNT Circle

Location

Kind of Pipe

Size 6"

Size of Main 8"

~~Repair~~ ~~Renewal~~ New Service Valeri #0088

Location

Date	Material	Amount	Total	Date	Amount
0/4/80	30' 6" REP @ \$14.00		\$420.00	11-1-80	210.00
11/15/90	265' 6" PVC				
	5' 4" PVC			9-4-80	
	1 4" x 6" Reducer			30' 6" TRANSITE	
	2 SMH (1 Being A Drop MH)			1 6" X 8" Wye	
	1 Wye				
	Bend 22°				
	22° Sweep				


DATE 11-15-1920

TOWN OF LEXINGTON — BOARD OF PUBLIC WORKS

SEWER DIVISION

36 OAKMOUNT CIRCLE

Sketch of Service Here (BACK OF HOUSE) 36

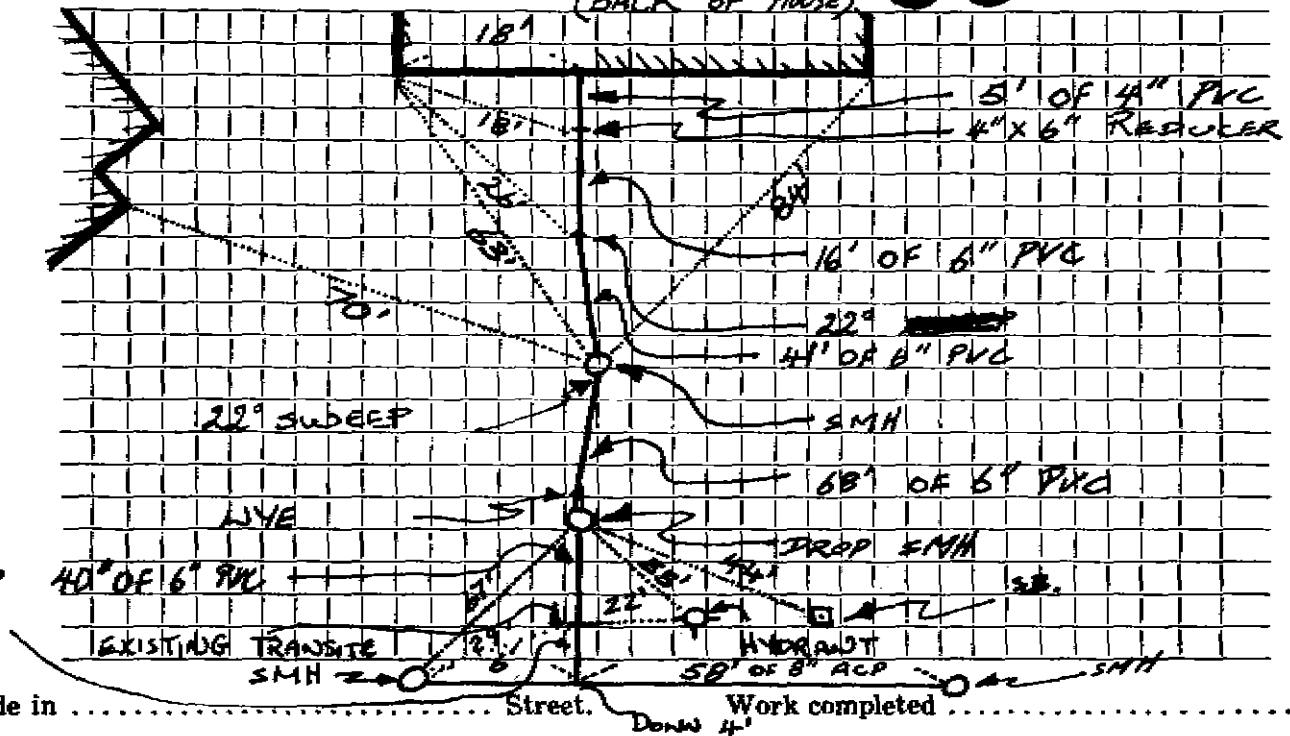

Connection made in Street. Work completed Down 4'

Remarks:

CONNECTION MADE IN MERIAM ST. INSPECTED 11-15-20 BY P. BARROWS

INSTALLED BY VALERI CONSTRUCTION