

Name

Service No.

Address **4 OAKMONT CIR.**

4 OAKMONT Circle

Location

Kind of Pipe

Size **6"**

Size of Main **8"**

Repair—Renewal—New Service Suburbanaite #2371


Location

Date	Material	Amount	Total	Date	Amount
8/13/73		NO CHARGE			
11-1-	73 118' - 6" ACP				
	10' - 4" CI				

TOWN OF LEXINGTON — BOARD OF PUBLIC WORKS

SEWER DIVISION

Sketch of Service Here **4**

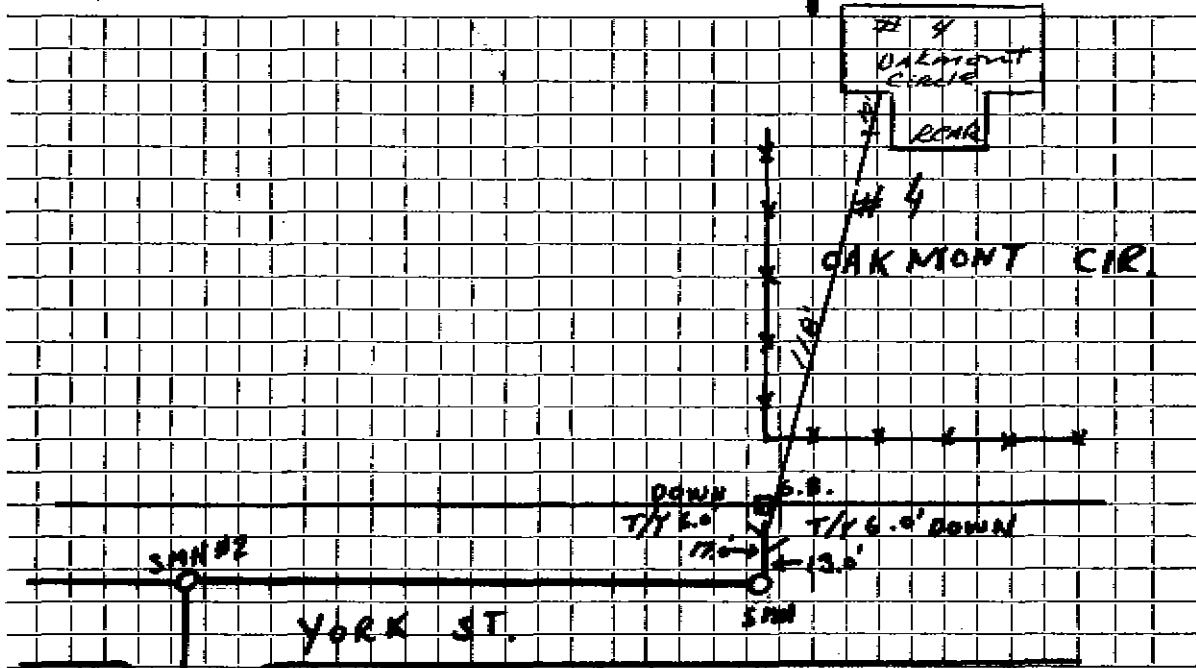

Connection made in Street. Work completed

Remarks:

.....

.....