




SEWER DIVISION

Sketch of Service Here

6

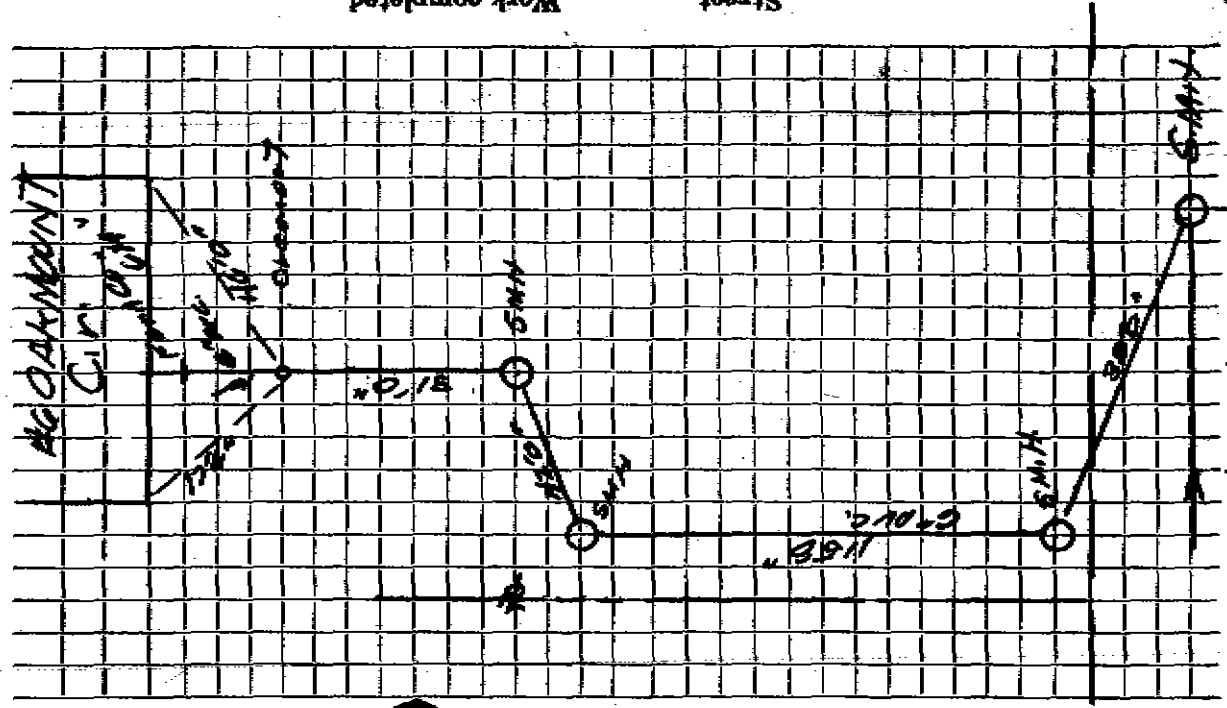

Work completed

Street

Connection made in

Remarks: