


DATE _____

TOWN OF LEXINGTON — BOARD OF PUBLIC WORKS
SEWER DIVISION

Sketch of Service Here

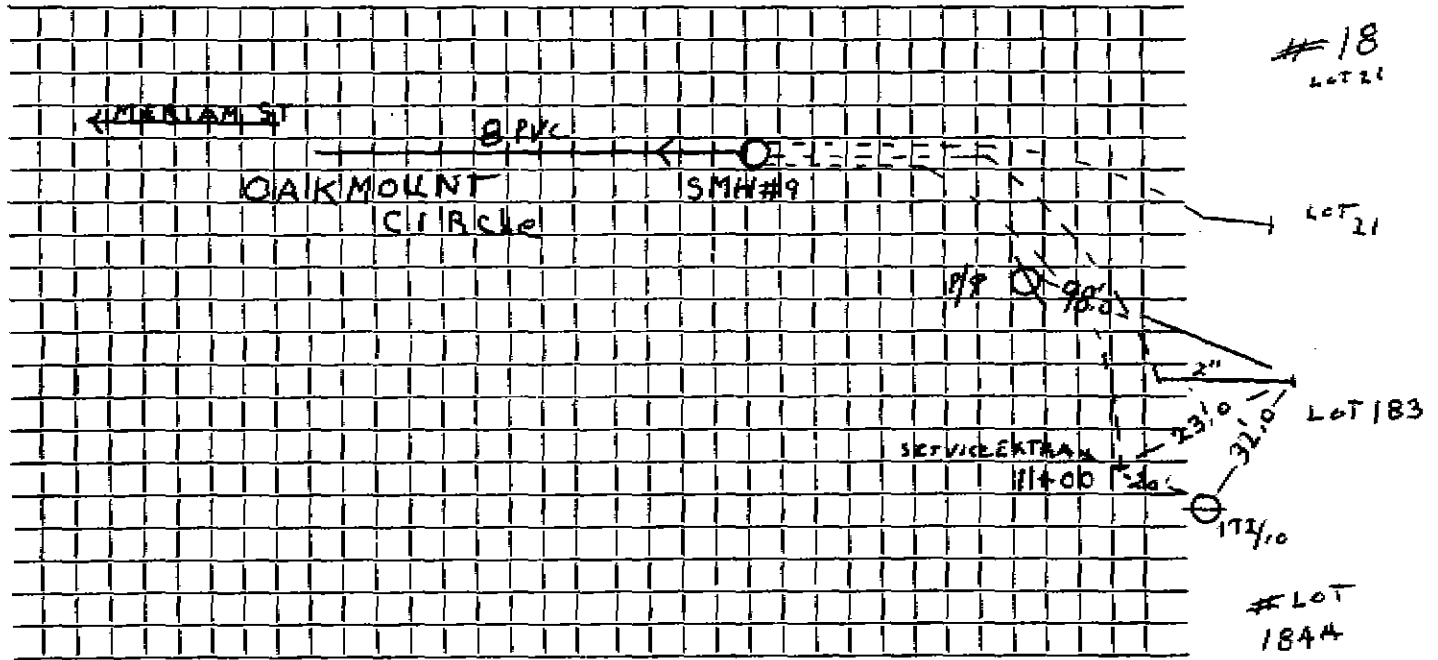

Connection made in Street. Work completed 7/2008

Remarks: 2" Force MAIN / 3- Service lines 2" PVC