


DATE _____

TOWN OF LEXINGTON — BOARD OF PUBLIC WORKS

SEWER DIVISION

Sketch of Service Here

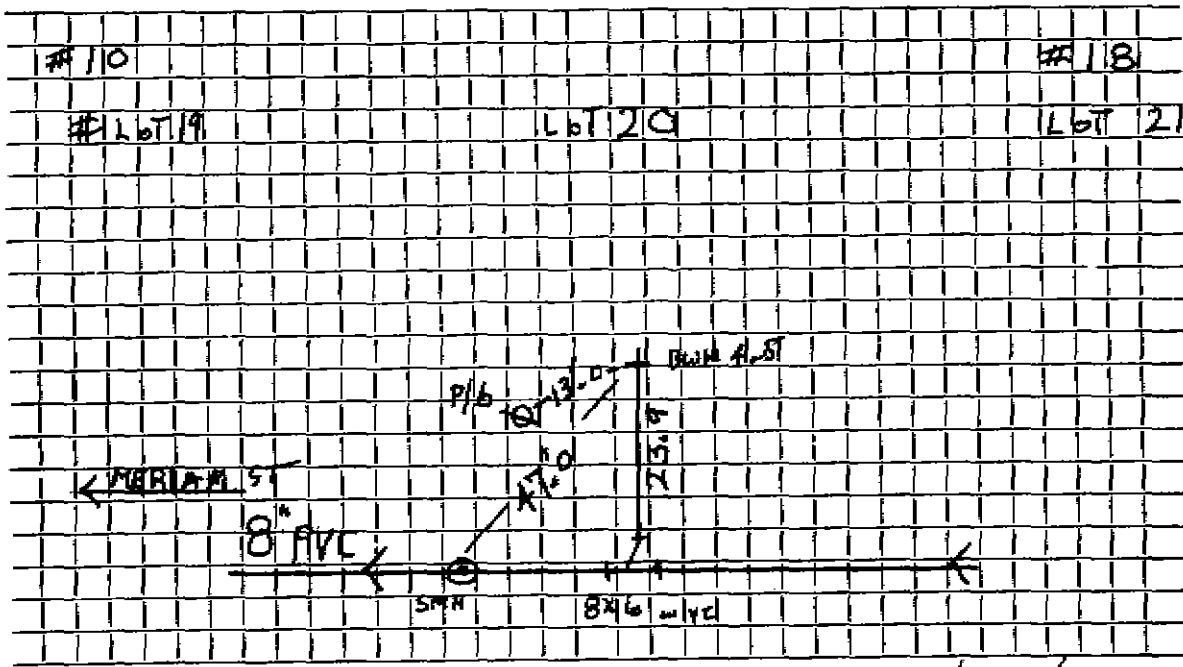

Connection made in OAKMONT CIR Street. Work completed 7/15/08

Remarks:

.....

.....