

Name 11 Old Shade St.

Service No. 91

Address Howard A. LeVaux

11 Old Shade ST.

Location Lot L.C. 39

Kind of Pipe

Size 6"

Size of Main 8"

~~XXXXXXXXXX~~ New Service Trebino permit # 2124


Location AUG 14 1972

| Date    | Material                                    | Amount            | Total                                       | Date            | Amount           |
|---------|---|-------------------|---|-----------------|------------------|
| 1971    | <del>75' 6" A-C transite pipe @ 12.00</del> | <del>900 00</del> |   | 6-20-71         | Deposit 220.00   |
|         |   | \$ 720 00         | - As per Board of Selectmen action - 5/8/72 |                 |                  |
|         |   |                   |   | 1971            | OK Grand Council |
| 7/19/72 | 60' 6" Transite                             |                   |   | 75' 6" Transite |                  |
|         | 10' 4" Cast Iron                            |                   |   | 1 6" X 8" Wye   |                  |

DATE \_\_\_\_\_

TOWN OF LEXINGTON — BOARD OF PUBLIC WORKS  
SEWER DIVISION

Sketch of Service Here **11**

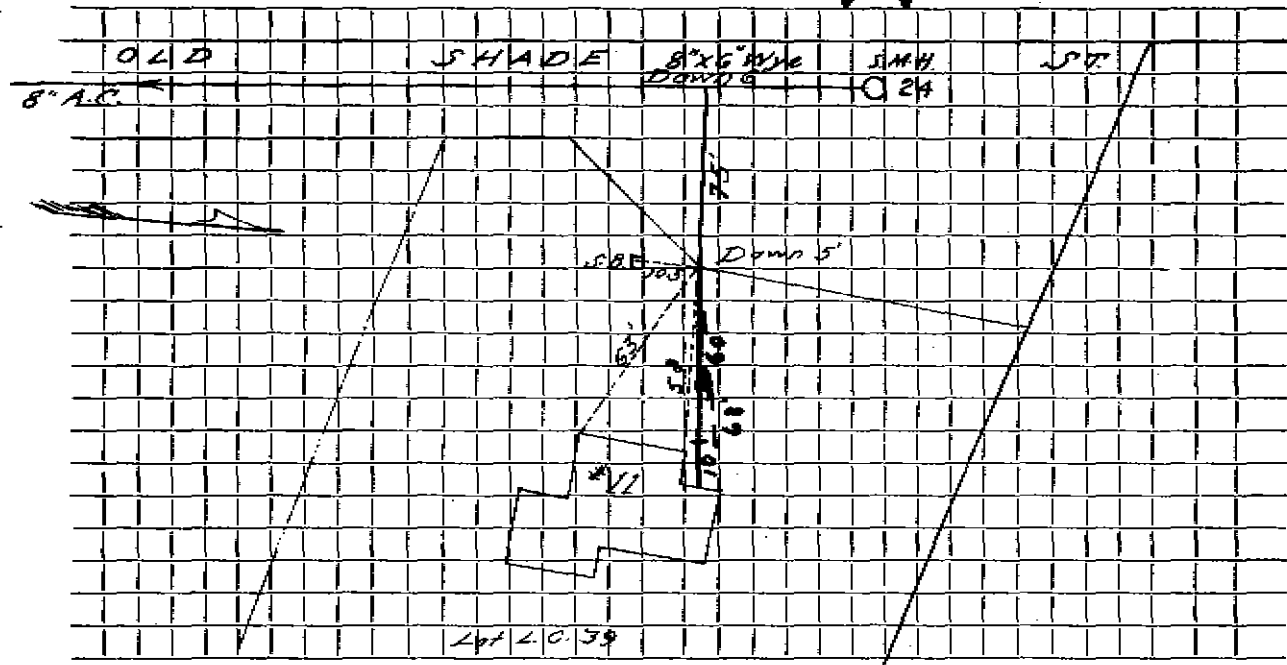

Connection made in ..... Street. Work completed .....

Remarks: .....  
.....  
.....