


DATE 3.18.98

TOWN OF LEXINGTON — BOARD OF PUBLIC WORKS

SEWER DIVISION

Sketch of Service Here

149 OLD SPRING.

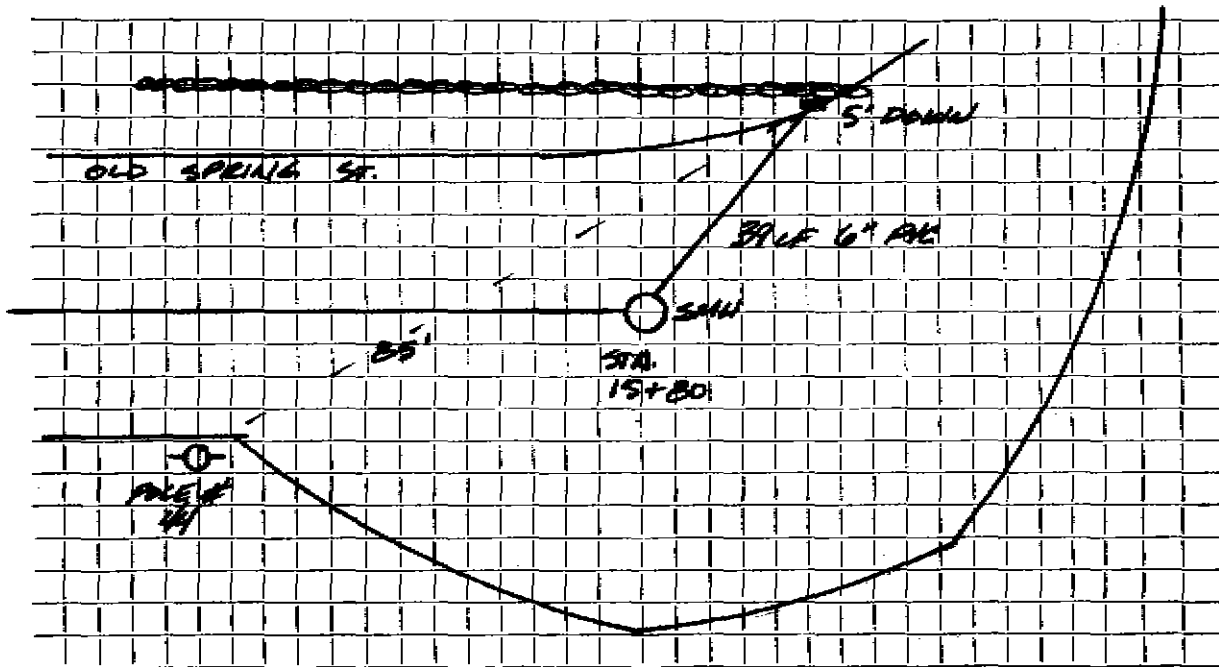

Connection made in Old Spring Street. Work completed CONTRACT 97-4

Remarks: