


DATE 3.18.98

TOWN OF LEXINGTON — BOARD OF PUBLIC WORKS

SEWER DIVISION

Sketch of Service Here

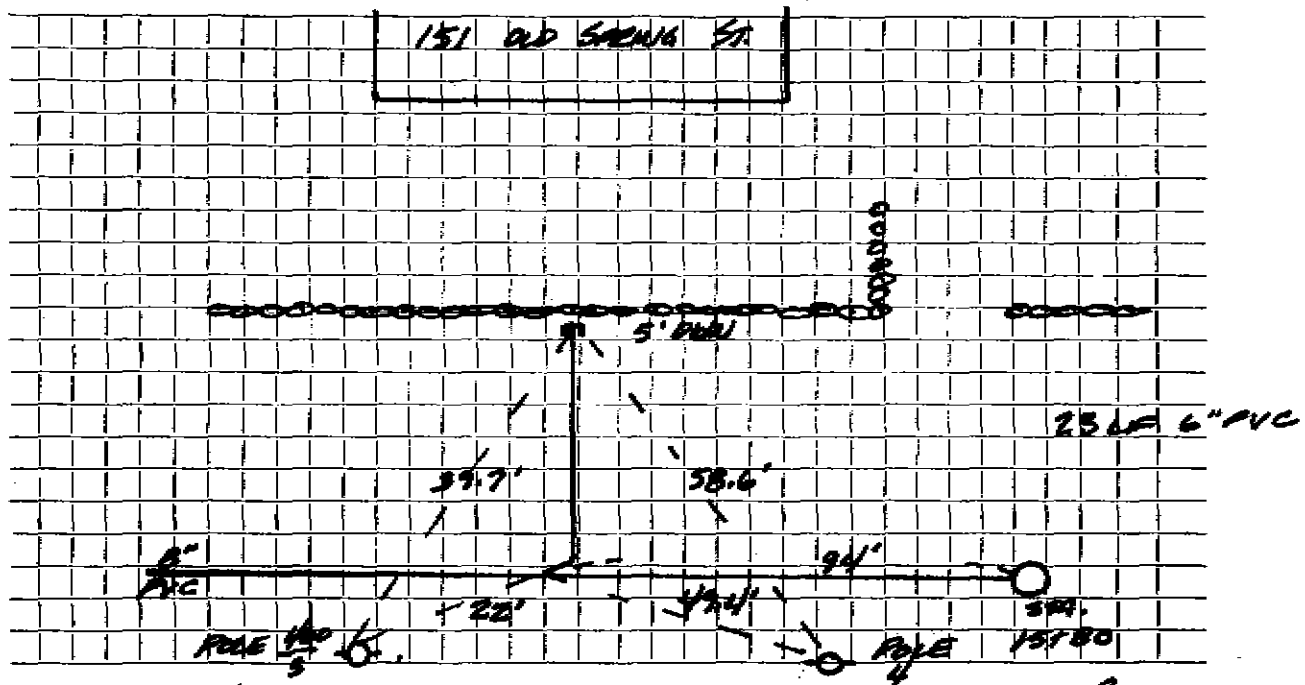

Connection made in OLD SPRING Street.

Work completed CONTRACT 97-4

Remarks: