

Name

Service No.

Address 152 OLD SPRING STREET

Location

Kind of Pipe PVC

Size 6"

Size of Main 8" PVC

Repair—Renewal—New Service


Location

Date	Material	Amount	Total	Date	Amount
12.8.97	B LF 6" PVC	\$ 46.00	\$ 320.00		
11.20.98	Inside installed				
	4x6 PVC FRP/CO				
	6x6 PVC FRP/CO				
	39' 6" PVC				
	6" 45° Bend				

DATE 3-18-98

TOWN OF LEXINGTON — BOARD OF PUBLIC WORKS
SEWER DIVISION

Sketch of Service Here

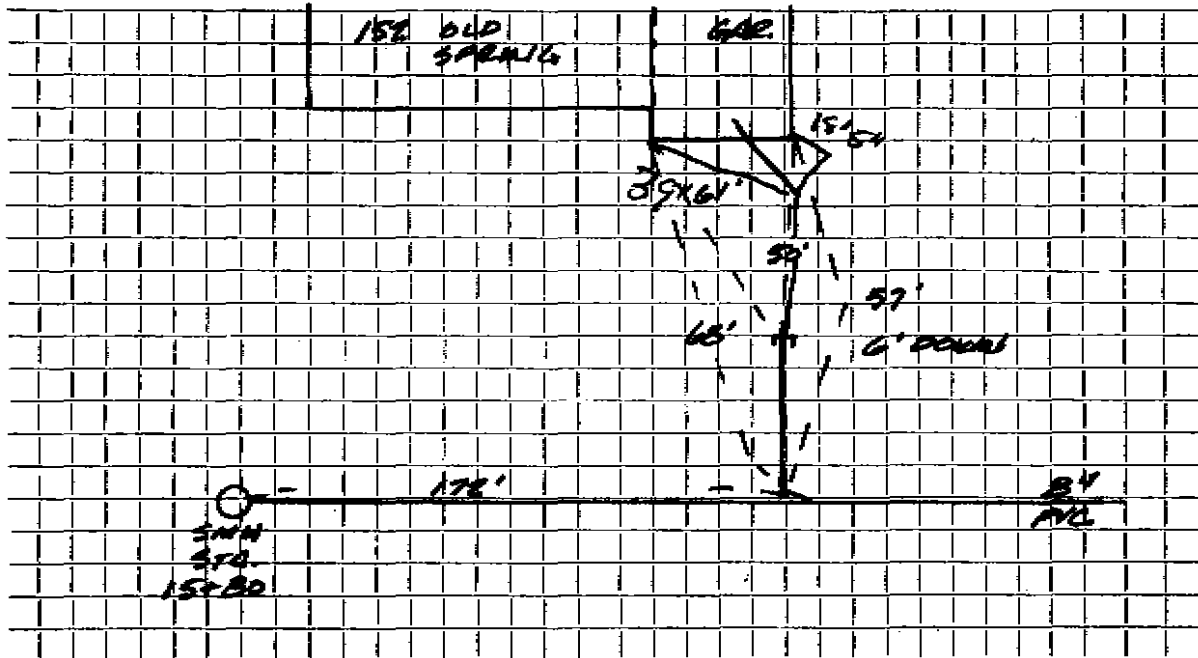

Connection made in OLD SPRING Street. Work completed CONTRACT 97-4

Remarks:

.....

.....