


DATE 3-18-98

TOWN OF LEXINGTON — BOARD OF PUBLIC WORKS

SEWER DIVISION

Sketch of Service Here

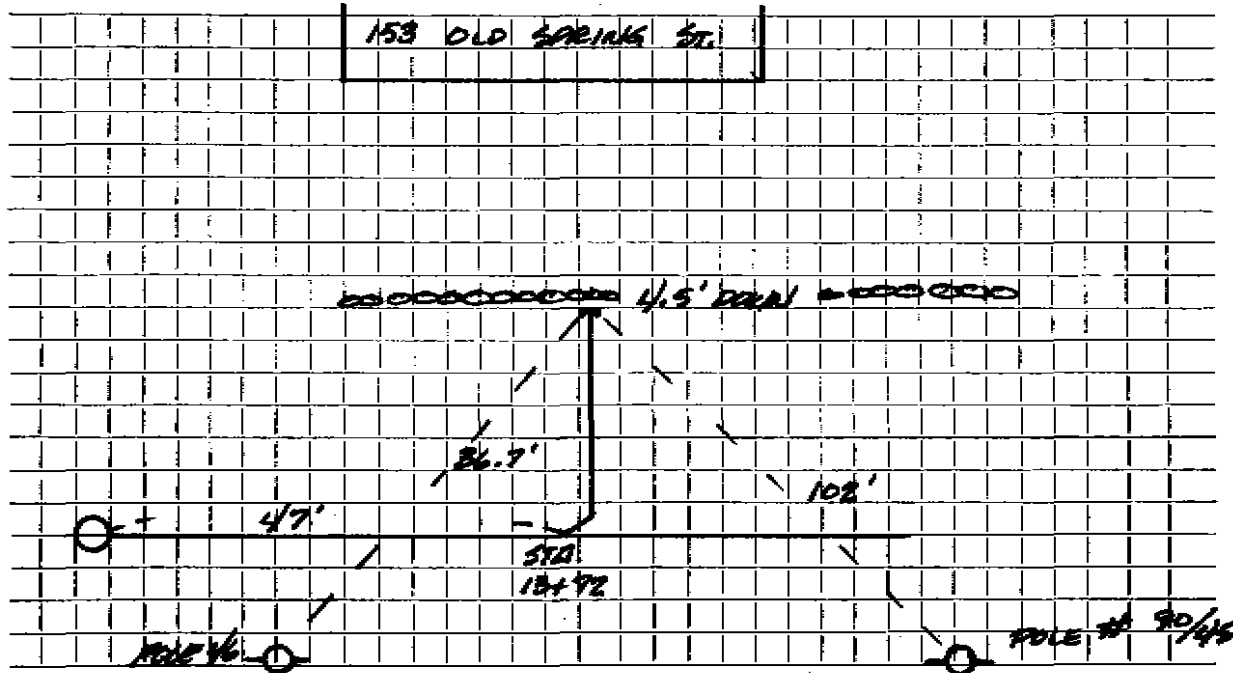

Connection made in OLD SPRING Street.

Work completed CONTRACT 974


Remarks:
.....
.....

DATE _____

TOWN OF LEXINGTON — BOARD OF PUBLIC WORKS

SEWER DIVISION

Sketch of Service Here 153

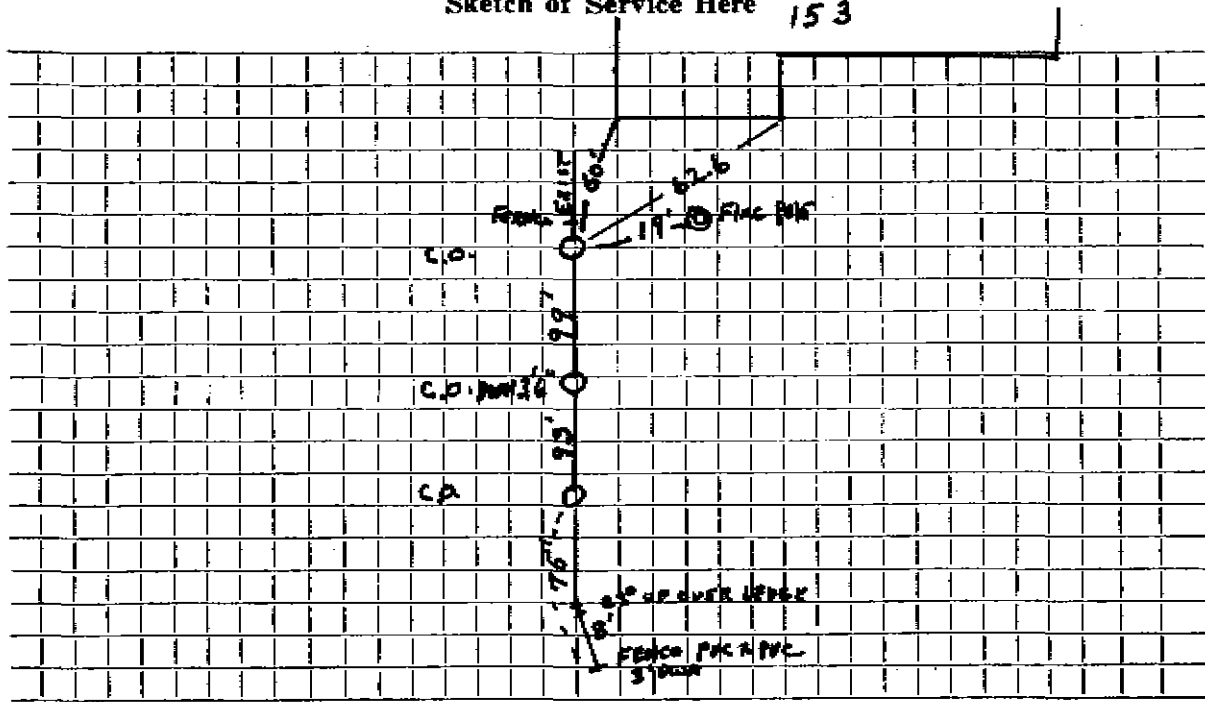

Connection made in OLD SPRING ST Street. Work completed

Remarks:

.....