




DATE \_\_\_\_\_

TOWN OF LEXINGTON — BOARD OF PUBLIC WORKS  
SEWER DIVISION

Sketch of Service Here

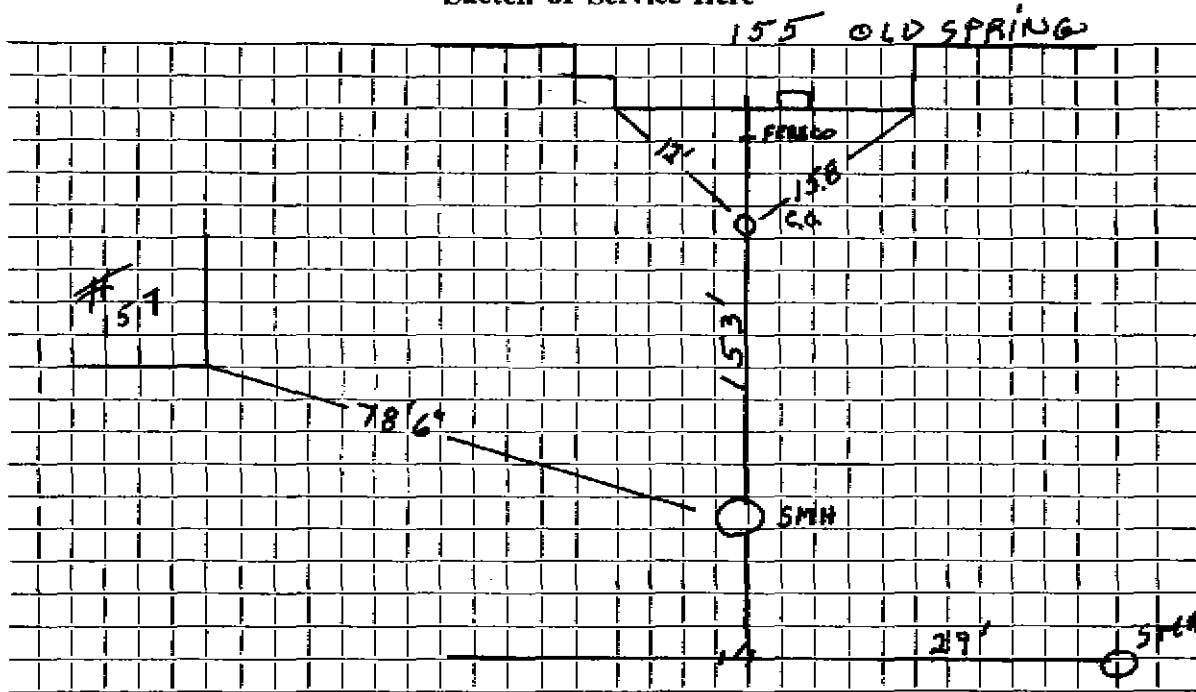

Connection made in OLD SPRING Street. Work completed 9/98

Remarks: SEE 2ND COND. ENG. CONTRACT. IN P.P. AM ?