

Name 157

Service No.

Address 159 Old Spring St.

Ruggieri - (Contractor)

Location

Kind of Pipe PVC

Size 6"

Size of Main 8"

Repair—Renewal—New Service

Location


Date	Material	Amount	Total	Date	Amount
9-17-98	154' 6" PVC Pipe				
	2-6" PVC-PVC Fern.				
	1-6" 6x6x6 Elbow				

TOWN OF LEXINGTON — BOARD OF PUBLIC WORKS

SEWER DIVISION

DATE _____

Sketch of Service Here

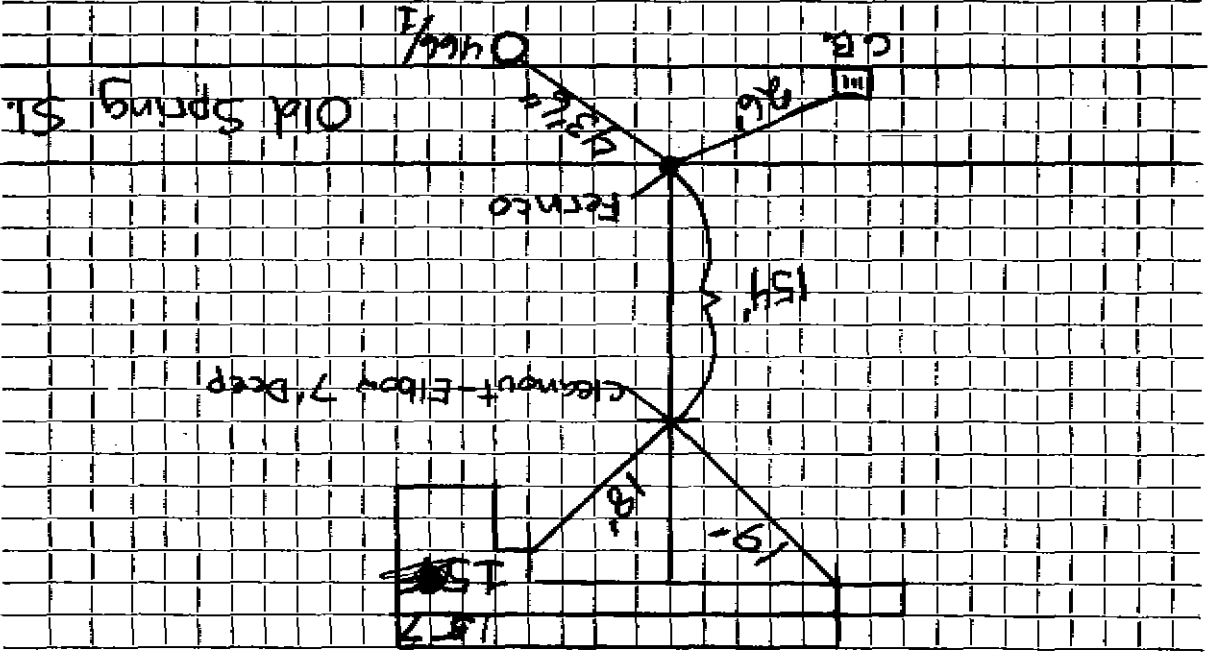

Connection made in _____ Street. Work completed _____

Remarks: _____