


DATE 3.18.78

TOWN OF LEXINGTON — BOARD OF PUBLIC WORKS
SEWER DIVISION

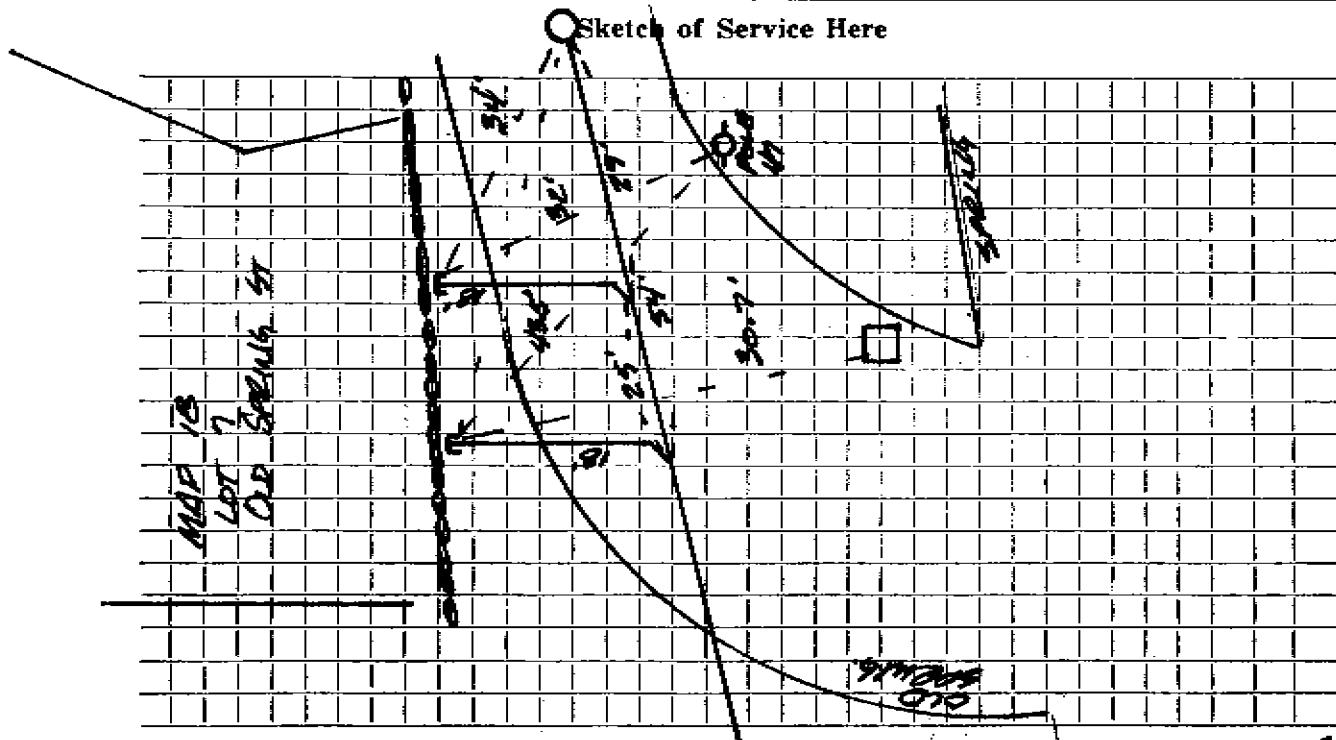

Connection made in Old Spring Street. Work completed Contract 97-4

Remarks:

.....

.....