




DATE \_\_\_\_\_

**TOWN OF LEXINGTON — BOARD OF PUBLIC WORKS**  
**SEWER DIVISION**

Sketch of Service Here  
#11 & #15 LOT 16

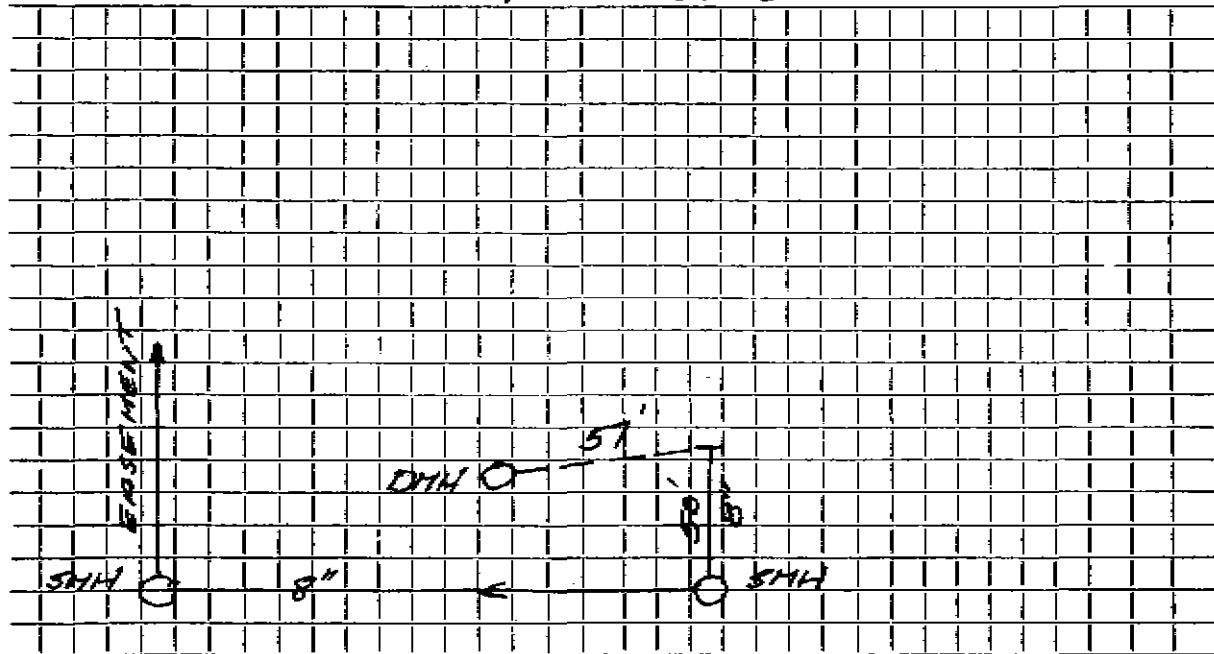

Connection made in ORCHARD LANE Street. Work completed .....

Remarks: MULTI-UNIT DWELLING .....