


DATE _____

TOWN OF LEXINGTON — BOARD OF PUBLIC WORKS

SEWER DIVISION

Sketch of Service Here

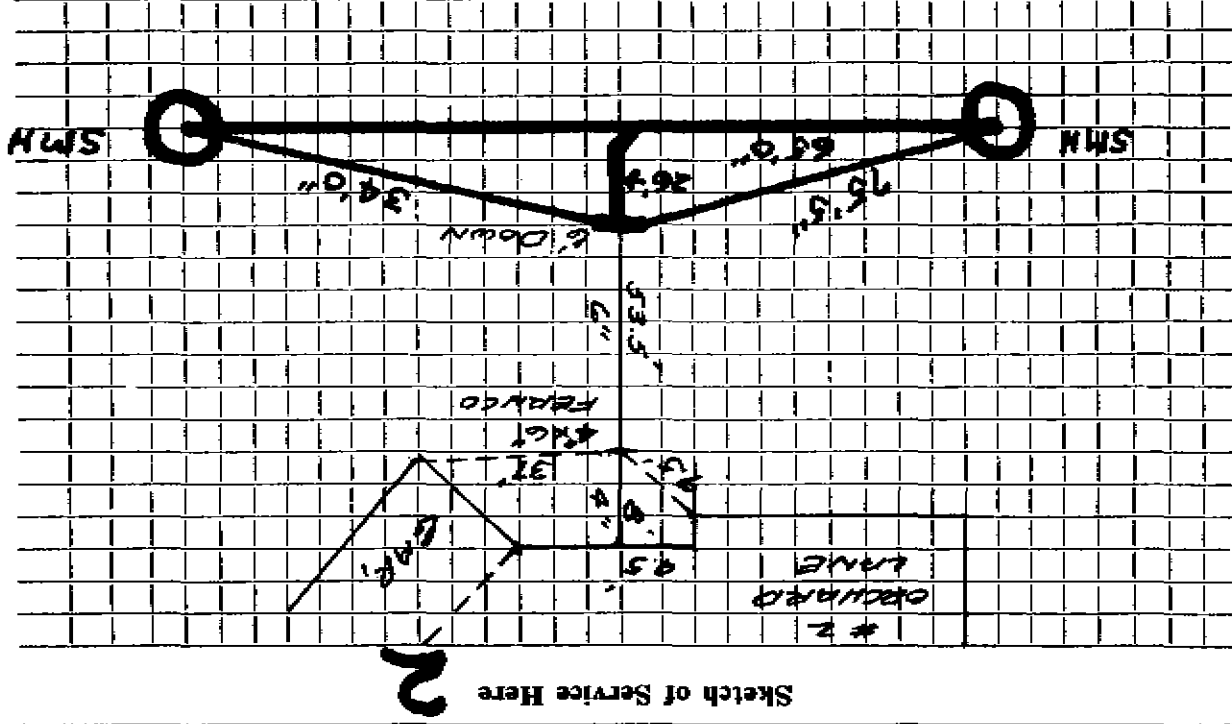

Work completed

Street.

ORCHARD LANE

Connection made in

Remarks: