




DATE \_\_\_\_\_

# TOWN OF LEXINGTON — BOARD OF PUBLIC WORKS

## SEWER DIVISION

Sketch of Service Here

**4**

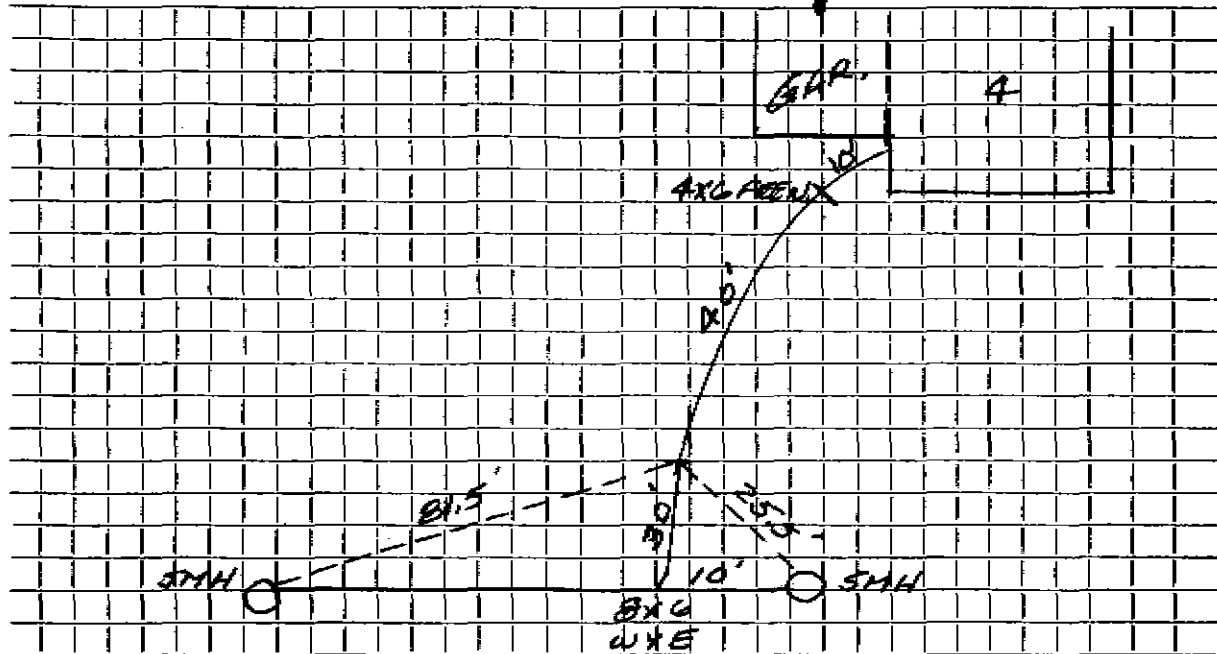

Connection made in ORCHARD LANE Street. Work completed .....

Remarks: .....

.....

.....