


DATE _____

TOWN OF LEXINGTON — BOARD OF PUBLIC WORKS
SEWER DIVISION

Sketch of Service Here #678 LOT 16 **678**

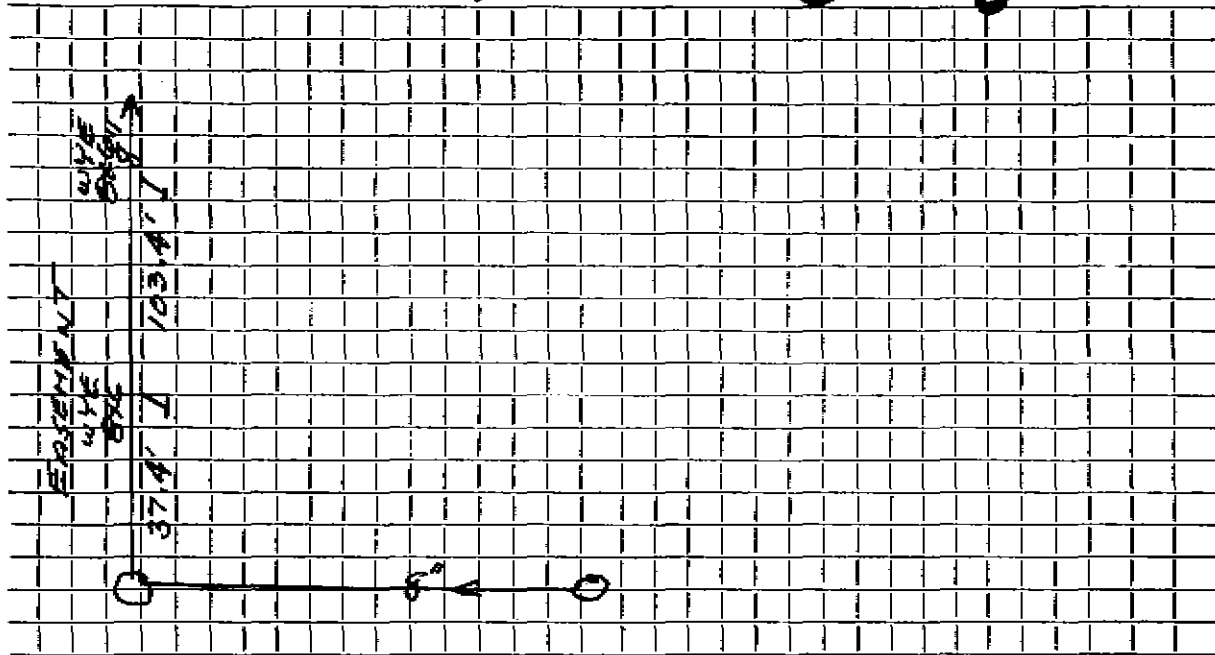

Connection made in EASEMENT Street. Work completed

Remarks: MULTI-UNIT DWELLING