


DATE _____

TOWN OF LEXINGTON — BOARD OF PUBLIC WORKS

SEWER DIVISION

Sketch of Service Here
7549 LOT 16

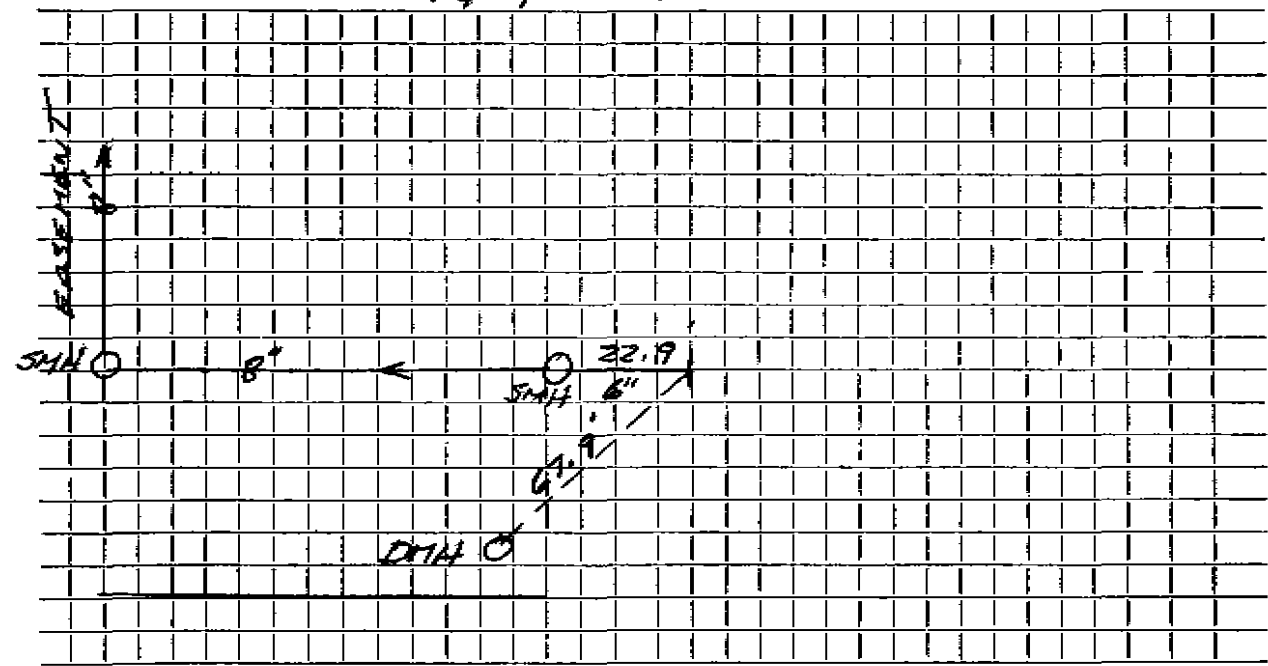

Connection made in ORCHARD LANE Street. Work completed

Remarks: MULTI-UNIT DWELLING

.....
.....