




DATE 10-7-91

TOWN OF LEXINGTON — BOARD OF PUBLIC WORKS  
SEWER DIVISION

Sketch of Service Here

7

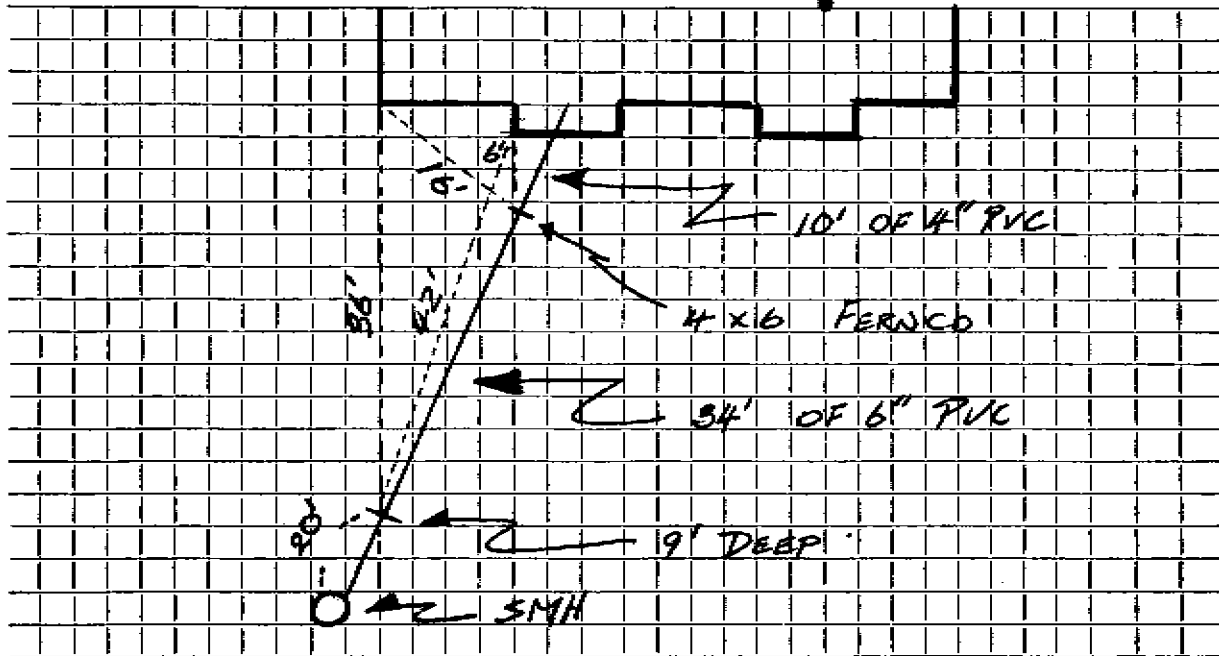

Connection made in ORCHARD LADE ~~Street~~

Work completed BY CARDILLO & SONS

Remarks: .....