


TOWN OF LEXINGTON — BOARD OF PUBLIC WORKS
DATE _____

SEWER DIVISION

10 1/2 R 21 R 3/2 LOT 16

Sketch of Service Here

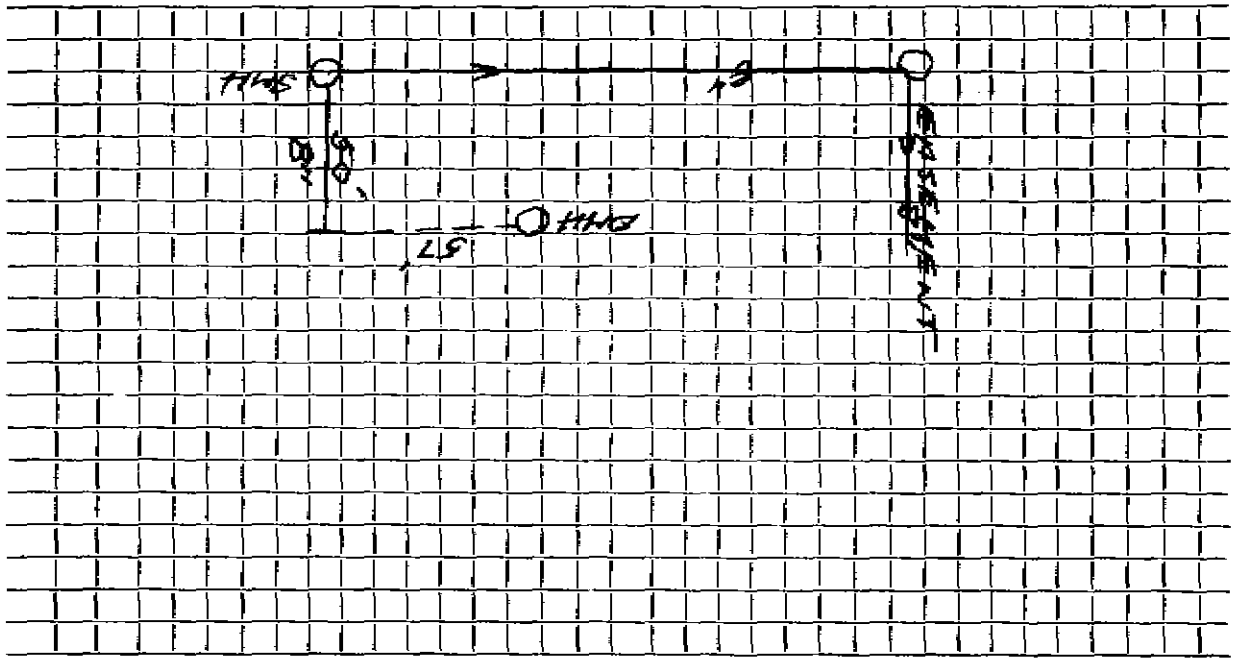

Connection made in **BOGARD LANE**

Street.

Work completed

Remarks: **MULTI-UNIT DWELLING**