




DATE \_\_\_\_\_

# TOWN OF LEXINGTON — BOARD OF PUBLIC WORKS

## SEWER DIVISION

Sketch of Service Here

8

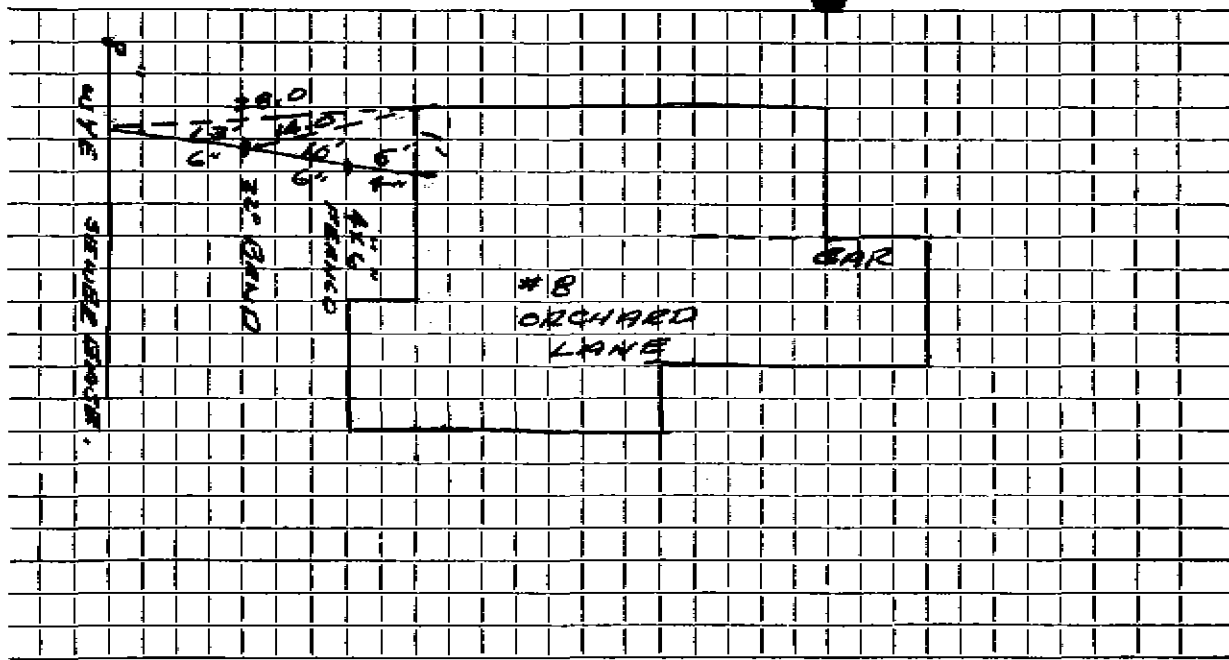

Connection made in EASEMENT Street. Work completed .....

Remarks: .....  
 .....  
 .....