




DATE \_\_\_\_\_

TOWN OF LEXINGTON — BOARD OF PUBLIC WORKS

SEWER DIVISION

Sketch of Service Here

9

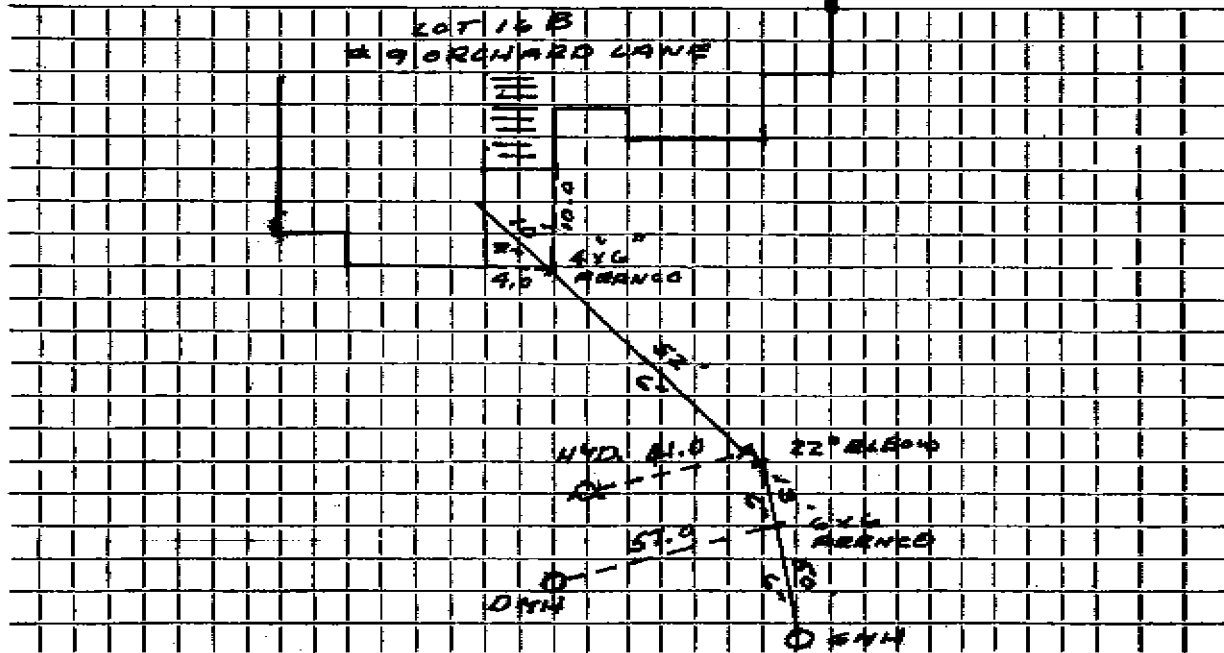

Connection made in ORCHARD LANE Street. Work completed .....

Remarks: .....

.....

.....