

Lot 176

Service No. 109

Name Stephen A. Russell
Address 11 Outlook Drive

Lexington, Mass.

Location

Kind of Pipe

Size 6"

Size of Main 8"

~~REPLACEMENT~~ — New Service

C.M. 11-13-51

Location

Date	Material	Amount	Total	Date	Amount
L/51	Labor	23 94	23 94	<i>8-25-51</i>	<i>Deposited</i> 125 00
	10% overhead		2 39	<i>11-13-51</i>	<i>Refused</i> 23 58
	54' - 6" sewer pipe @.342		18 47		101 42
	1 - 6" elbow		1 88		
	joint compound		3 24		
	5 hrs. Littlefield shovel	67.	35 00		
	2 hrs. trucking @ .75		1 50		
	patching 15 x 3		15 00		
			101 42		
	Labor				

Name Robert Sorrentino

Service No. 190

Address 12 Outlook Drive

Lexington, Mass.

Location

Kind of Pipe

Size 6"

Size of Main 8"

REPAIR/REPLACE - New Service

com. 12-31-51

Location

Date	Material	Amount	Total	Date	Amount
1/28/51	Labor	54 40		11-15-51	Deposited 125 00
1/29/51	"	21 76		5-1-52	Paid (1 75
	10% overhead	7 62	83 78		Outside 129 75
	58' -6" sewer pipe @ .342		19 83	4-5-95	146-6" PVC
	1 - 6x6 Tee		1 16		2-6' CI-PVC Franco
	joint compound		3 48		2-6" PVC-PVC " "
	4 hrs. Town shovel @ 5.00		20 00		2 22" Bends
	2 hrs. trucking		1 50		1-6X6X4 Tee
			129 75		3'-4" PVC
					1-4" Donut
				Bill sent 12-31-51	
				" " 3-21-52	
	Labor			9-30-94	Responds + Measure CT
					Possible Problem 64'

TOWN OF LEXINGTON—DEPT. OF PUBLIC WORKS
SEWER DIVISION

DATE

NO.


The undersigned applies for the construction of a particular sewer connecting No.
 Street and hereby agrees to comply with the Rules and Regulations governing the construction and use of Particular
 Sewers, as now or at any future time established by the Board of Selectmen.

Am't of estimate \$.....

Am't Paid \$.....

..... Owner

Sketch of Service Here **12**

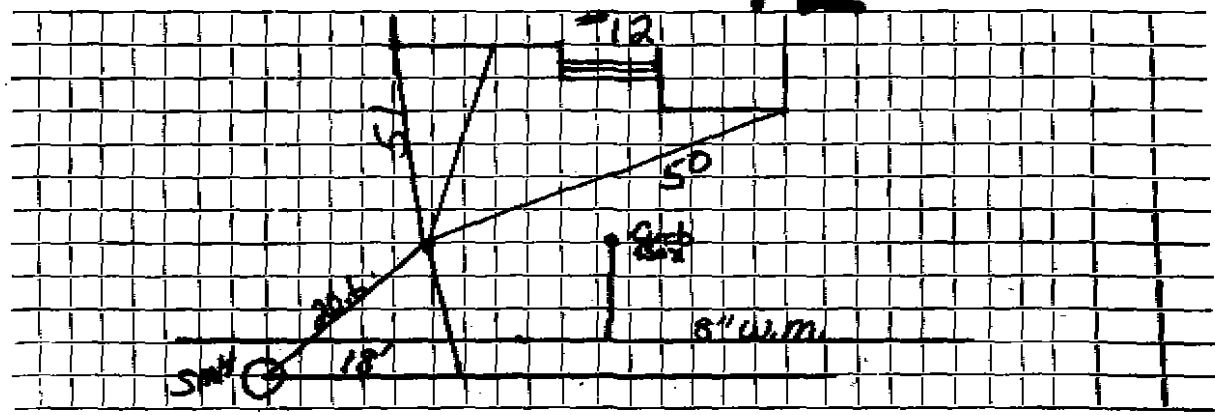

Connection made in Street.

Work completed **4.5... 19.25**

Remarks: **Both #12 + 11 Tie into same chimney**

TOWN OF LEXINGTON—DEPT. OF PUBLIC WORKS
SEWER DIVISION

DATE

NO.

The undersigned applies for the construction of a particular sewer connecting No.
Street and hereby agrees to comply with the Rules and Regulations governing the construction and use of Particular
Sewers, as now or at any future time established by the Board of Selectmen.


Am't of estimate \$.....

Am't Paid \$.....

..... Owner

Sketch of Service Here

11

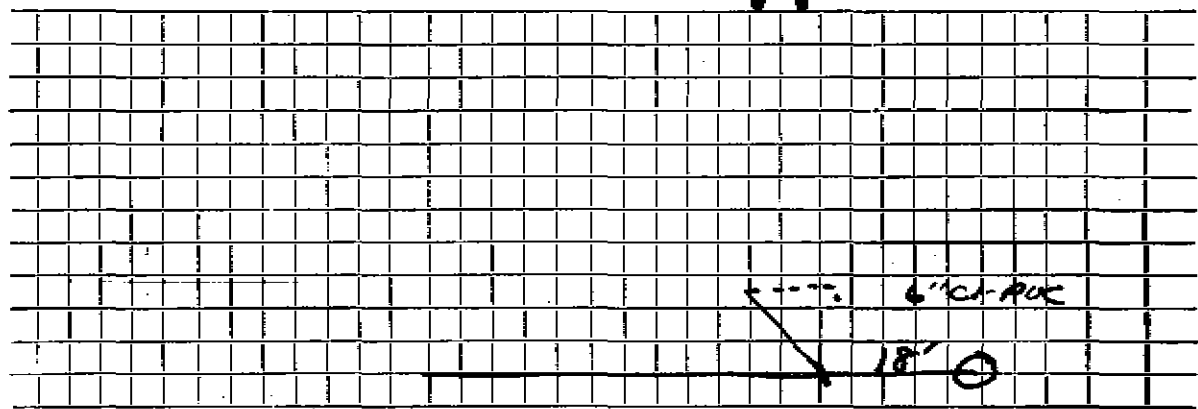

Connection made in Street.

Work completed 4-5-1925

Remarks: Repair made @ Tee 4 1/2-6" PVC #11 + 12 use same
Chimney