

Name **Wm. Anderson**

Service No. 123

Address **16 Outlook Drive**

Lexington

Location

Kind of Pipe **COM. 9-22-52**

Size **6"**

Size of Main **8"**

~~Repair~~ **New Service**

Location

Date	Material	Amount	Total	Date		Amount
8/28/52	Labor	45 30		8-13-52	Deposited	125 00
	10% Overhead	4 53	49 83	9-22-52	Refunded	(23 30)
	1/6' - 6" sewer pipe @.342		15 73			91 70
	1 - 6" elbow @1.88		1 88			
	joint compound		2 76	3-8-59	We will Respond	
	1/4 hr. Town shovel @5.00		20 00		& Measure	
	2 hr. trucking		1 50			
			91 70			
				4-21-91	Roots	
	Labor			5-19-91	Roots	

TOWN OF LEXINGTON—DEPT. OF PUBLIC WORKS

SEWER DIVISION

DATE.....

NO.


The undersigned applies for the construction of a particular sewer connecting No.....
 Street and hereby agrees to comply with the Rules and Regulations governing the construction and use of Particular
 Sewers, as now or at any future time established by the Board of Selectmen.

Am't of estimate \$.....

Am't Paid \$.....

..... Owner

Sketch of Service Here **16**

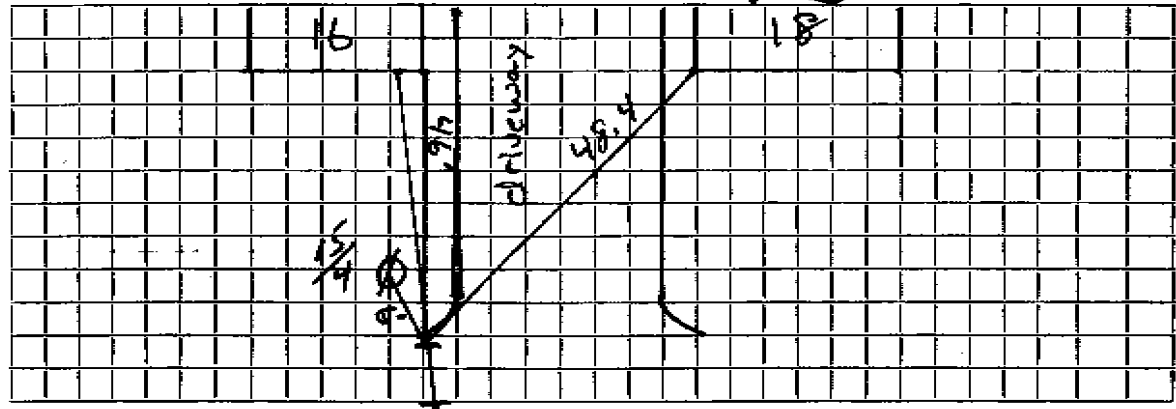

Connection made in..... Street.

Work completed.....19..

Remarks:

*Furnace 7' deep
 Clay Inside + outside Repair made with 6'-6" pvc*