




**TOWN OF LEXINGTON — BOARD OF PUBLIC WORKS**

**SEWER DIVISION**

DATE \_\_\_\_\_

Sketch of Service Here

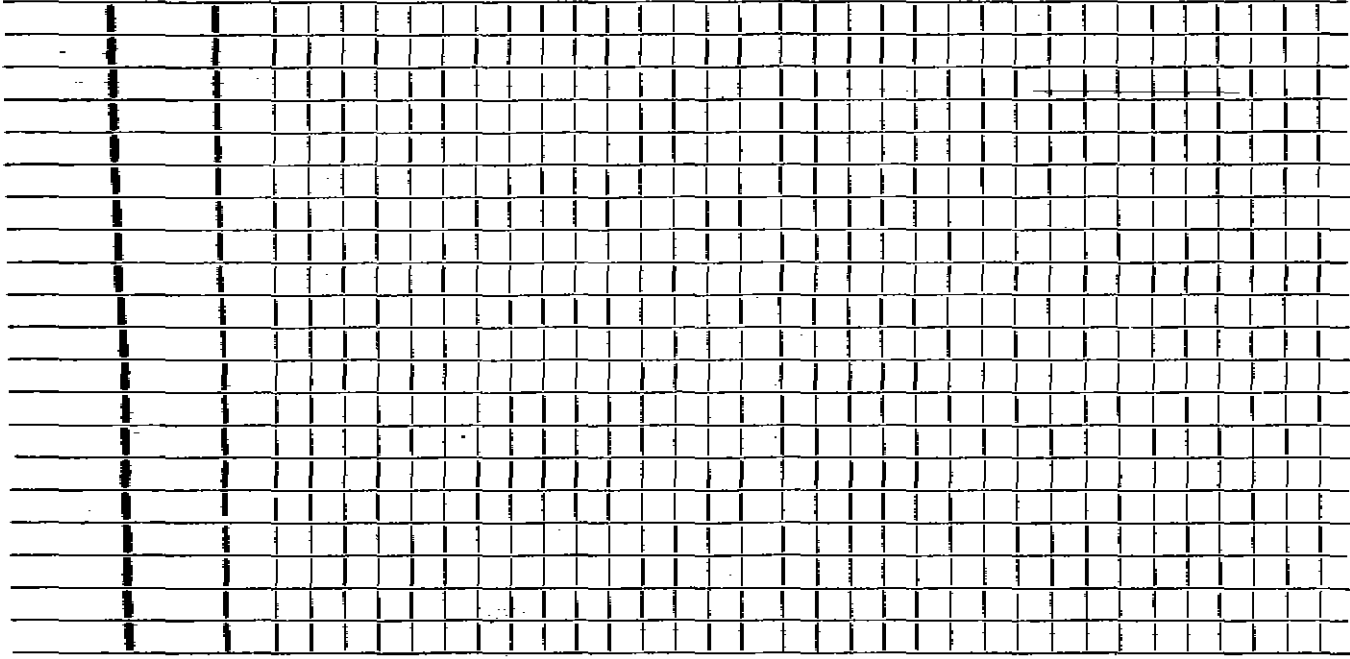

Work completed

Street.

Connection made in

Remarks: