

Name Lawrence Allen

Service No. 33

Address 22 Outlook Drive

22 Outlook Drive

Location

Kind of Pipe

Size 6"

Size of Main 8"

~~Repair~~ New Service

Location

Date	Material	Amount	Total	Date	Amount
4/23/56	Labor	48 53		4-18-56	Deposited \$ 200 00
	10% overhead	4 85	53 38	8-6-56	Refund 20 69
	60' - 6" Sewer pipe @ .3645		21.87		174 31
	Joint compound		3.60		
	1 - 6" Elbow		1 88		
	12 x 3 patching		12 00		
	9 1/3 hrs. Littlefield Shovel @ .50	8.50	79 33		
	3 hrs. trucking @ .75		2 25		
			174 31		
	Labor				

**TOWN OF LEXINGTON—DEPT. OF PUBLIC WORKS**  
**SEWER DIVISION**

DATE.....

NO. ....


The undersigned applies for the construction of a particular sewer connecting No.....  
Street and hereby agrees to comply with the Rules and Regulations governing the construction and use of Particular  
Sewers, as now or at any future time established by the Board of Selectmen.

Am't of estimate \$.....

Am't Paid \$.....

..... Owner

**Sketch of Service Here**

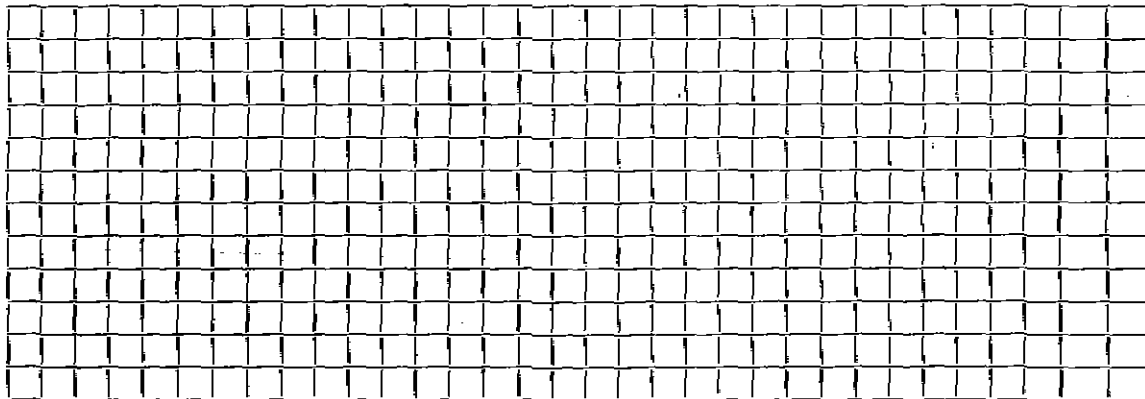

Connection made in..... Street.

Work completed..... 19..

Remarks: