

Name Jewett Contracting

Service No. 27

Address 30 A Outlook Drive

30A Outlook Drive

Location

Kind of Pipe

Size 6"

Size of Main 8"

~~Subscription~~ New Service V.O. #411 Varifans # 3227

Location

MAY 21 1979

Date	Material	Amount	Total	Date	Amount
5-11-79	Labor	137.58		5-8-79	Deposit
	10% O.A.H.	13.76	151.34	5-21-79	Paid by <u>W.P. #27</u>
5-11-79	6" Transit pipe @ 1.91		38.20	6-15-79	Paid
5-11-79	6" x 2' Nipple		6.11	5-11-79	338.29
5-11-79	6" x 8" Saddle		22.29		<u>6" Transit</u>
5-11-79	6" x 90° Elbow		6.21		<u>1 6" x 2' Nipple</u>
5-11-79	6" Gap		4.12		<u>1 6" - 90° Elbow</u>
5-11-79	hrs. Trucking @ 3.00		10.50		<u>1 6" x 8" Wye</u>
5-11-79	hrs. Backhoe @ 6.50		19.50		
	<u>Hot Top 13' x 15'</u>		<u>130.02</u>		
			<u>388.29</u>		
6-25-79	27' 6" Transit pipe				
10'	4" Cast iron pipe				


DATE _____

TOWN OF LEXINGTON — BOARD OF PUBLIC WORKS

SEWER DIVISION

Sketch of Service Here

30 A

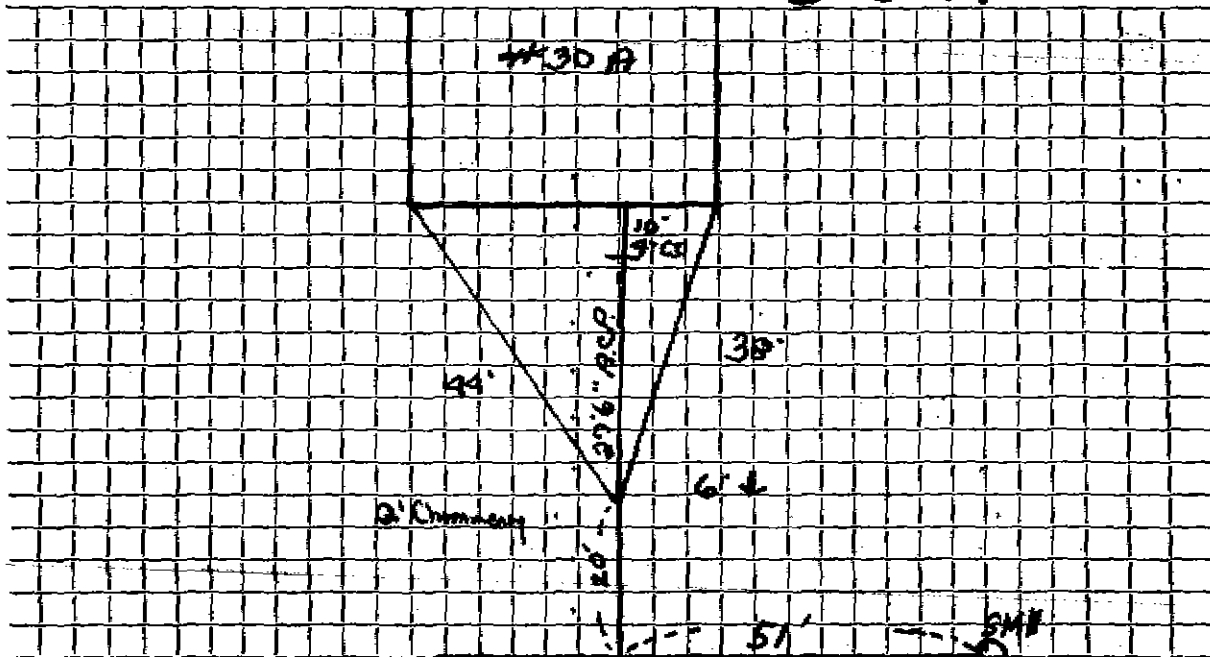

Connection made in Street. Work completed

Remarks:

.....

.....